


T.2S.R.37E.W.M.

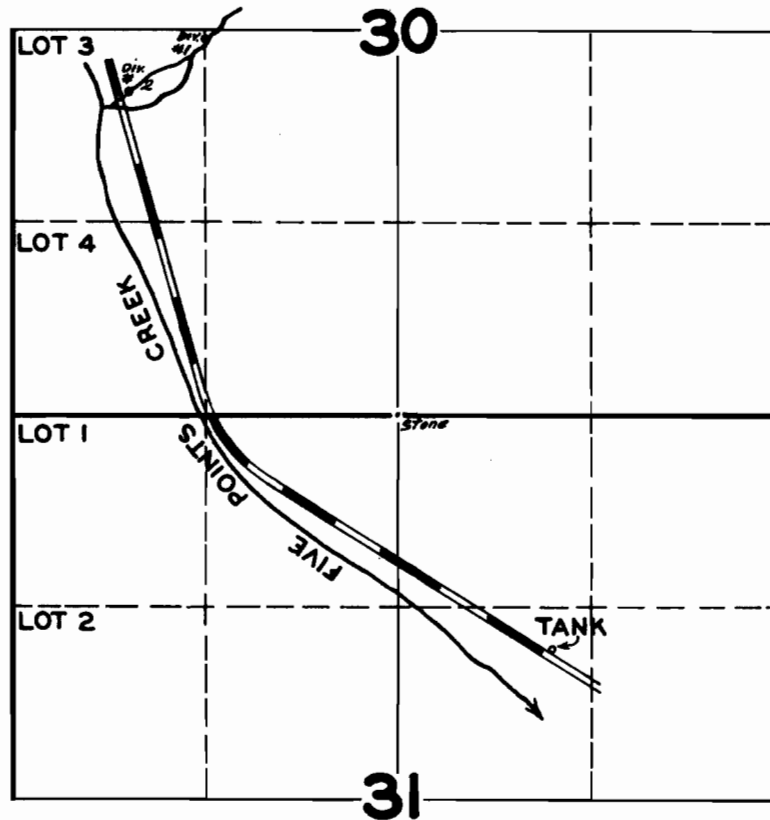

FINAL PROOF SURVEY
UNDER

Application No. 21621 Permit No. 16988

IN NAME OF

ORE.-WASH. RR. & NAV. CO. AND ITS LESSEE- UNION PAC. RR. CO.

Surveyed MAY 14, 1947, by JAS. E. BUNNELL