


T.10S.R.6W.W.M.

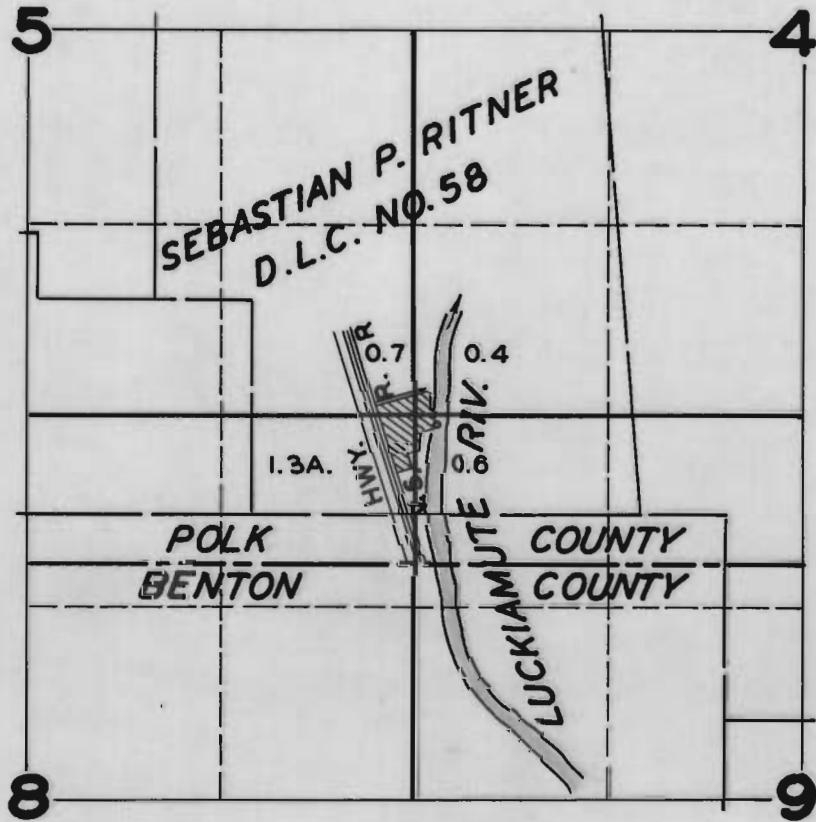

FINAL PROOF SURVEY
UNDER

Application No. 21638 Permit No. 17079
IN NAME OF

B. A. LYDAY

Surveyed APR. 6 1949, by JAS. E. BUNNELL