


T.I.S.R.I.W.W.M.

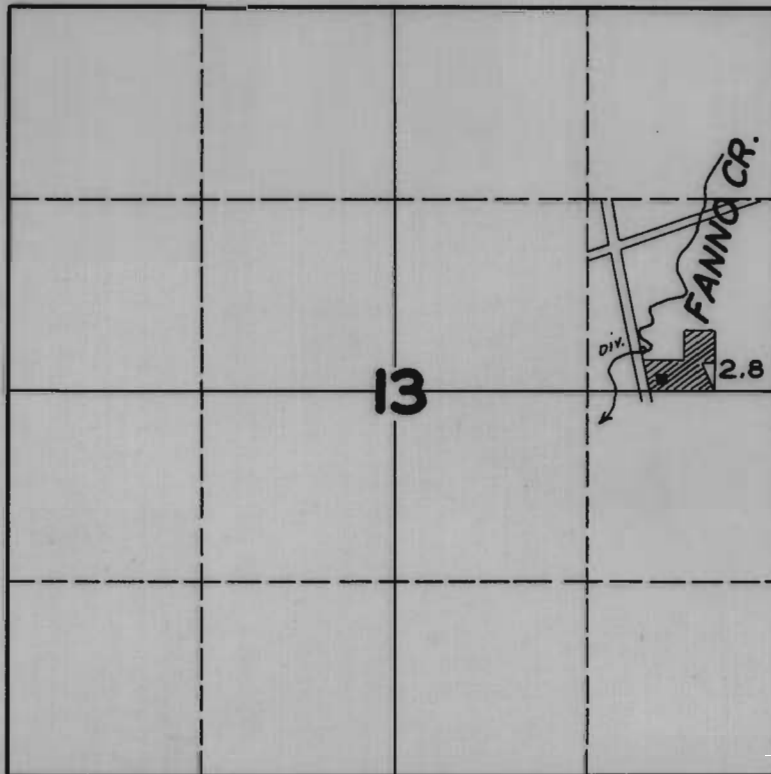

**FINAL PROOF SURVEY**  
UNDER

Application No. 21708 Permit No. 17097  
IN NAME OF

FRED M. POLCHOW

Surveyed MAY 6 1948, by JAS. E. BUNNELL