


# T.4S.R.IE.W.M.

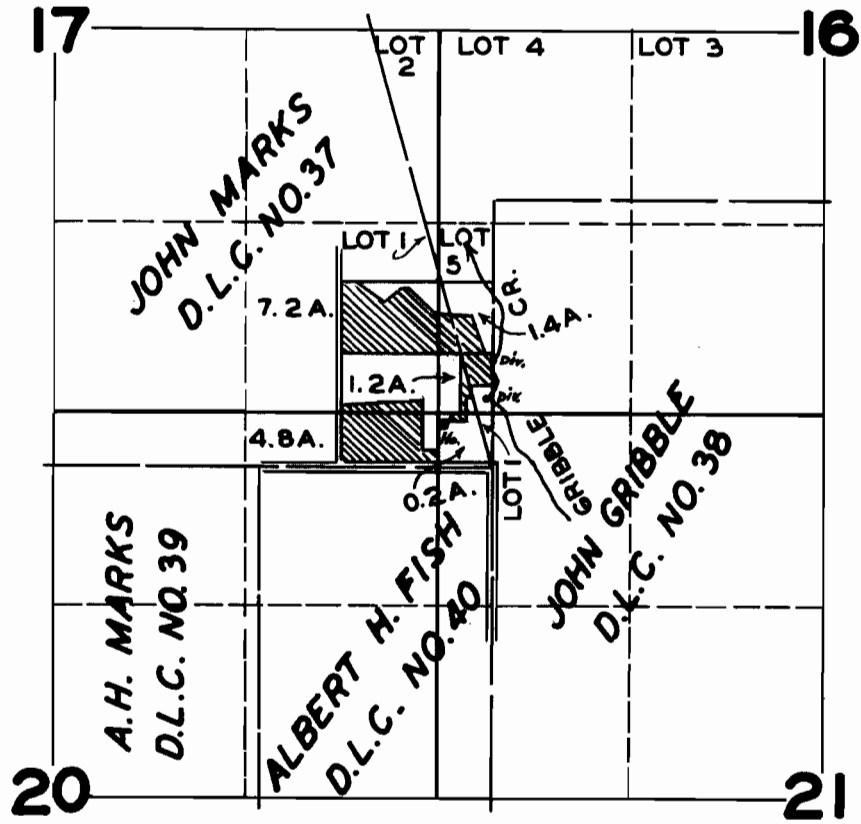

## FINAL PROOF SURVEY

UNDER

Application No. 21768 Permit No. 17124

IN NAME OF

E. L. MCCAULEY

Surveyed JULY 2, 1948, by JAS. E. BUNNELL