


T.13S.R.3W.W.M.

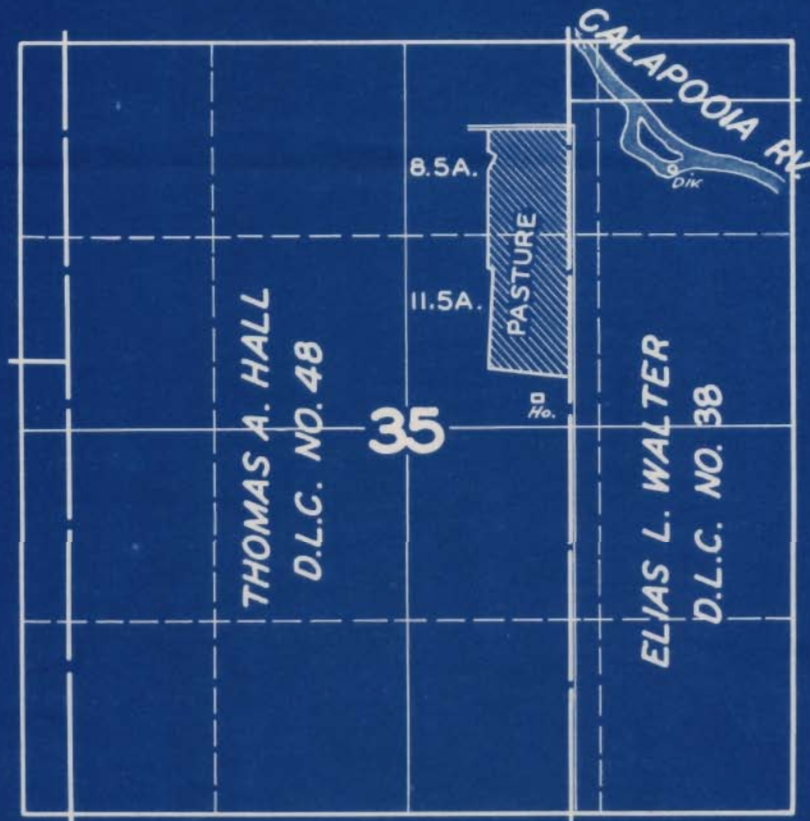

**FINAL PROOF SURVEY**  
UNDER

Application No. 21791 Permit No. 17144  
IN NAME OF  
**R. A. WARD**

Surveyed **SEP. 23 1948**, by **JAS. E. BUNNELL**