


**T.6N.R.35E.W.M.**

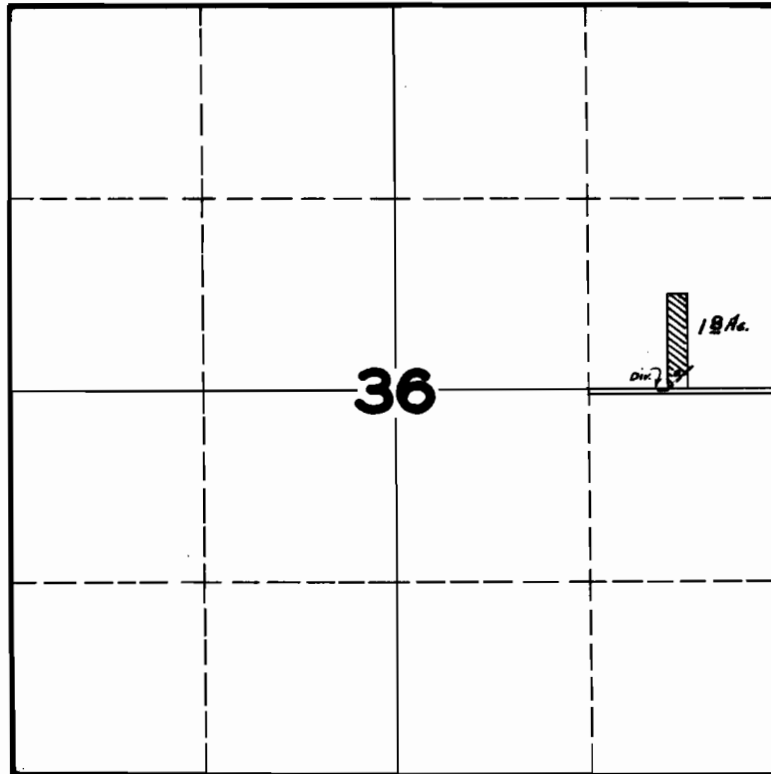

**FINAL PROOF SURVEY**  
**UNDER**

**Application No. 21820 Permit No. 17166**

**IN NAME OF**

**ROBERT L. McELROY**

**Surveyed APR. 22 1947, by JAS. E. BUNNELL**