


T.7S.R.3W.W.M.

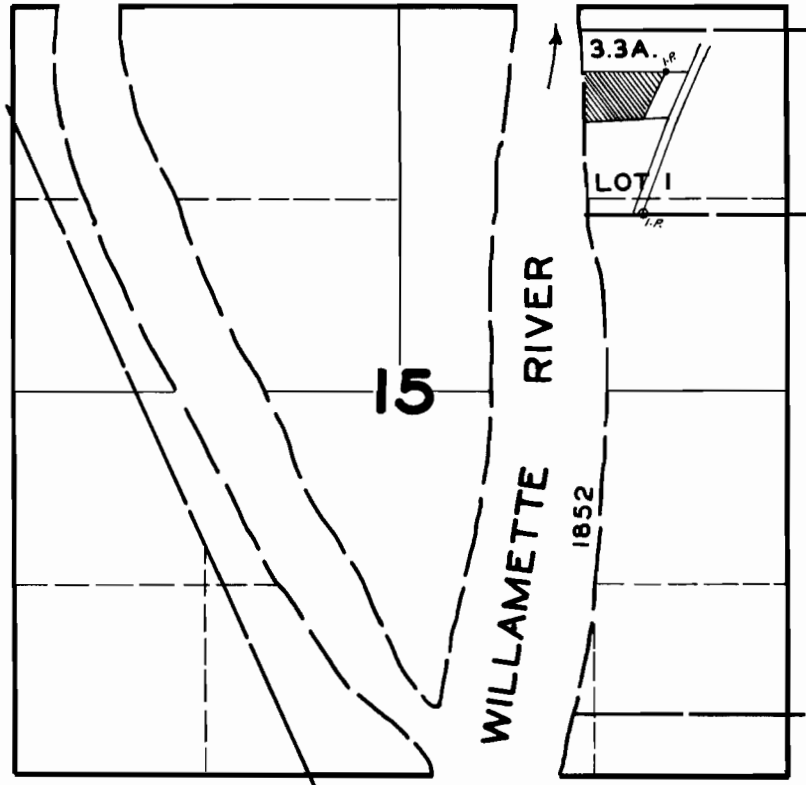

FINAL PROOF SURVEY
UNDER

Application No. **21836** Permit No. **17174**
IN NAME OF

E. J. DIETZ

Surveyed **AUG. 14, 1947**, by **JAS. E. BUNNELL**