


T.8S.R.3W.W.M.

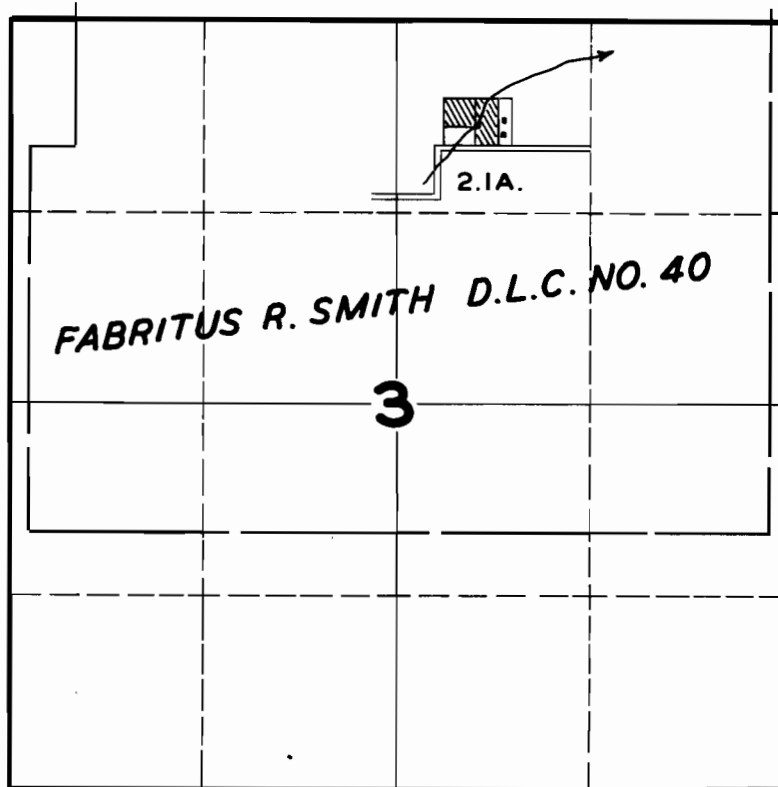

FINAL PROOF SURVEY
UNDER

Application No. **21842** Permit No. **17180**
IN NAME OF

M. B. THOMAS

Surveyed **APR. 22 1948**, by **JAS. E. BUNNELL**