


T.7S.R.3W.W.M.

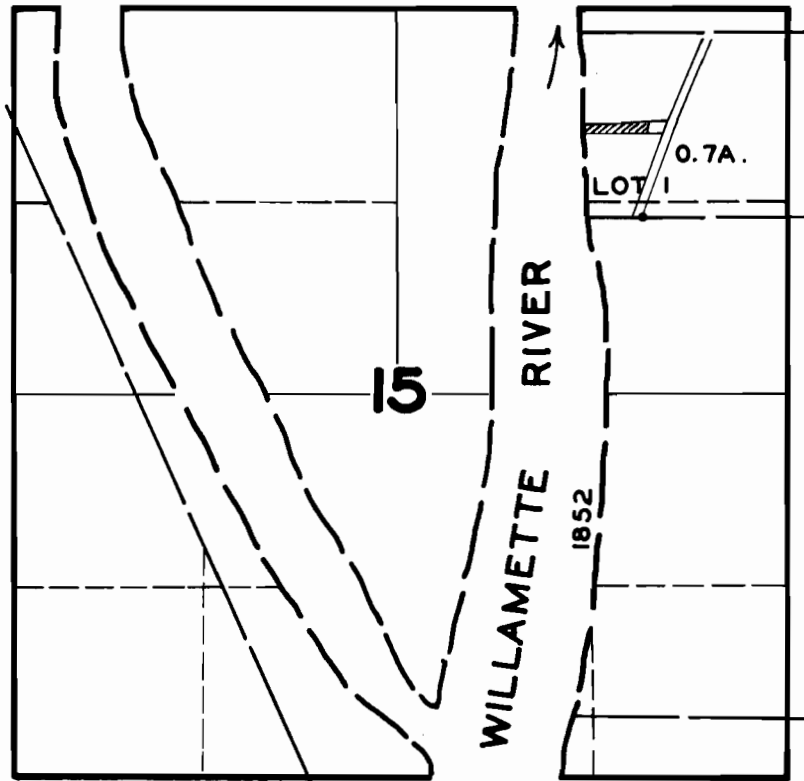

FINAL PROOF SURVEY
UNDER

Application No. **21843** Permit No. **17181**
IN NAME OF

F.A. MOORE

Surveyed **AUG. 14**, 1947, by **JAS. E. BUNNELL**