


# T.7S.R.4W.W.M.

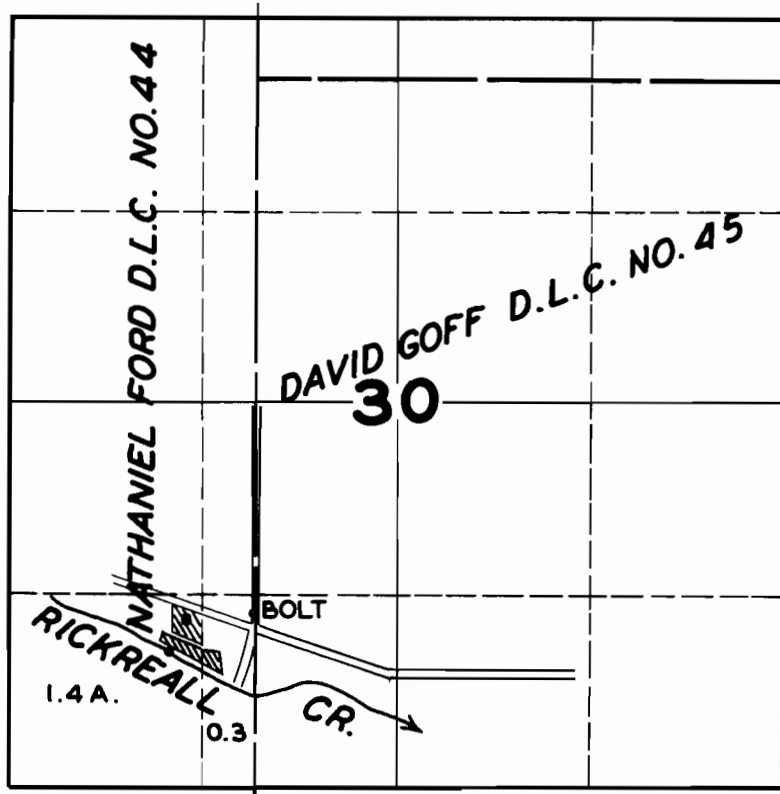

## FINAL PROOF SURVEY UNDER

Application No. 21852 Permit No. 17227  
IN NAME OF

MISS CAROLINE F. BURCH

Surveyed JULY 16, 1948, by JAS. E. BUNNELL