


T.4S.R.3E.W.M.

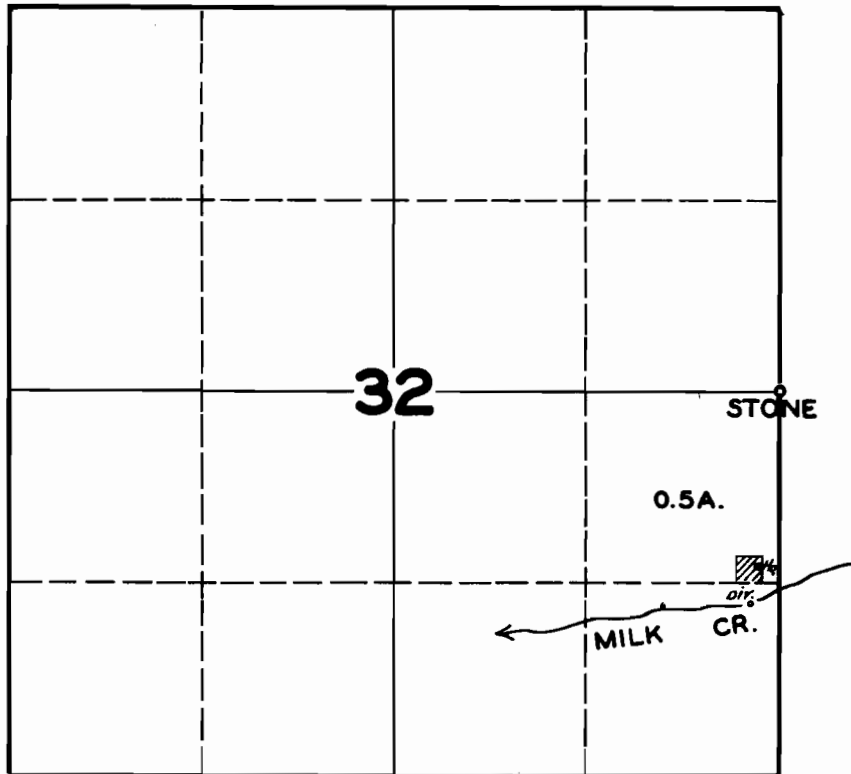

FINAL PROOF SURVEY

UNDER

Application No. **21860** Permit No. **17230**

IN NAME OF

RAYMOND HILL

Surveyed **SEP. 15, 1948**, by **JAS. E. BUNNELL**