


T.14S.R.2W.W.M.

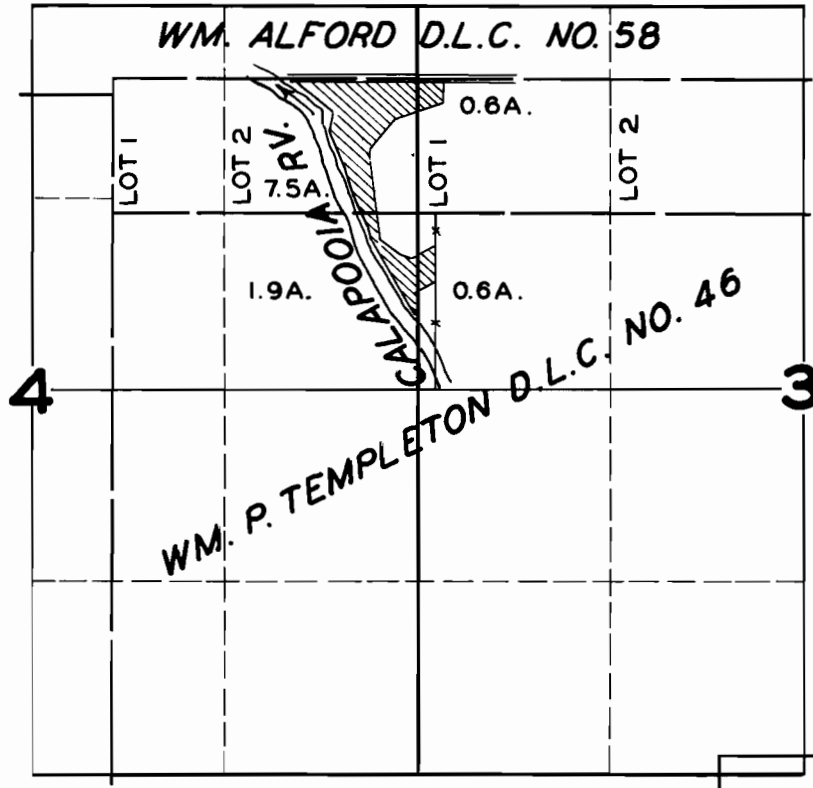

FINAL PROOF SURVEY UNDER

Application No. 21877 Permit No. 17233
IN NAME OF

AMOS & OSIE MISHLER

Surveyed APR. 26 1948, by JAS. E. BUNNELL