


T.8S. R.10W.W.M.

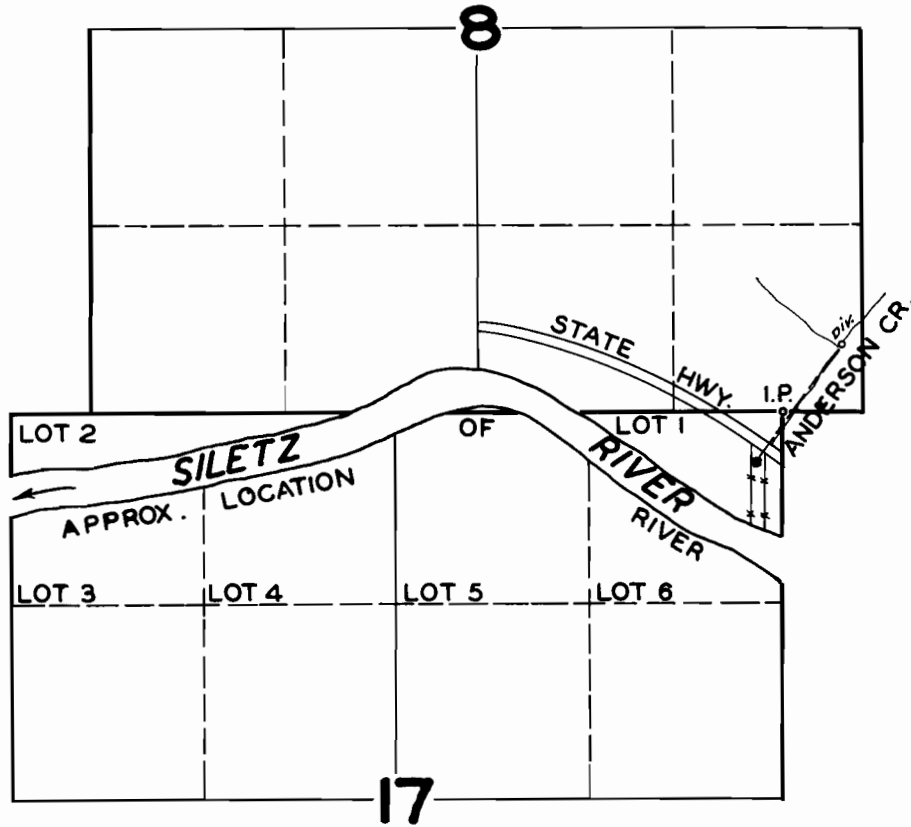

**FINAL PROOF SURVEY**  
UNDER

Application No. **21932** ... Permit No. **17261** ...  
IN NAME OF

**JOHN C. LAMB AND/OR CATHARINE LAMB**

Surveyed **AUG. 9, 1948**, by **JAS. E. BUNNELL**