


T.2S.R.4E.W.M.

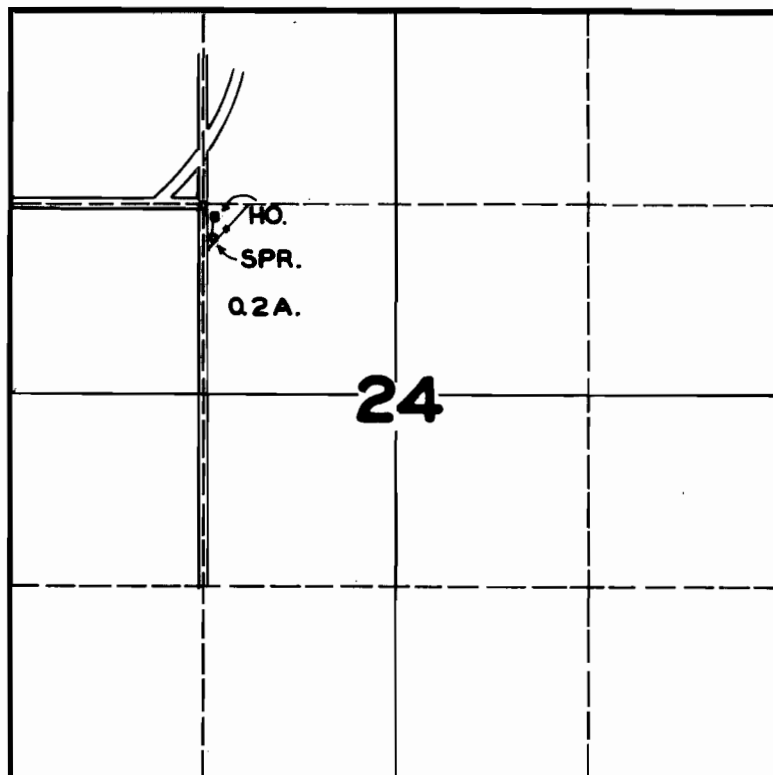

FINAL PROOF SURVEY
UNDER

Application No. 21943 Permit No. 17267
IN NAME OF

ADOLPH KOTZMAN

Surveyed SEP. 15 1948, by JAS. E. BUNNELL