


T.14S.R.IW.W.M.

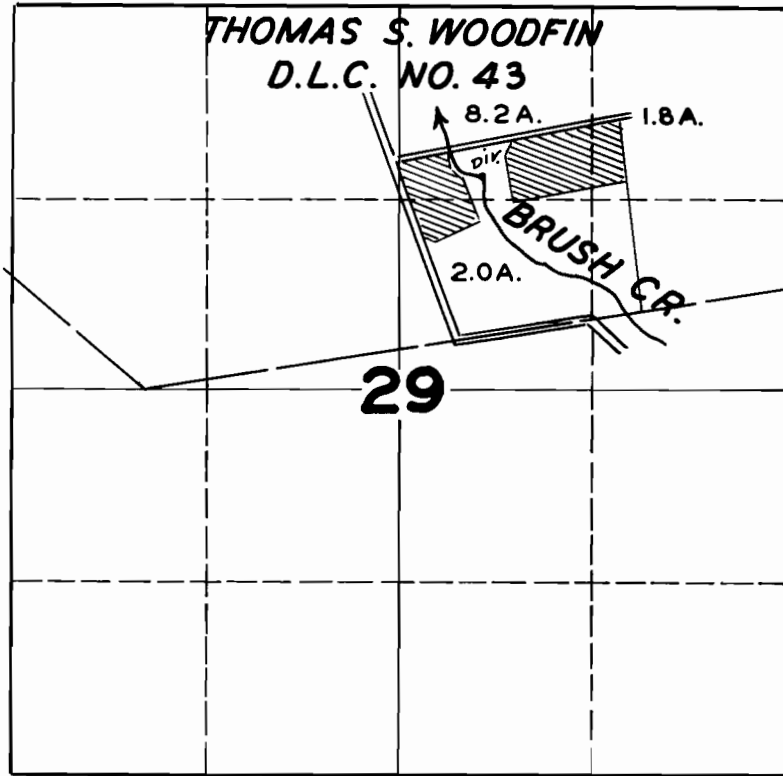

FINAL PROOF SURVEY UNDER

Application No. 21961 ... Permit No. 17274
IN NAME OF

RUSSELL THOMAS

Surveyed MAR. 28 1949, by JAS. E. BUNNELL