


T.15S.R.5W.W.M.

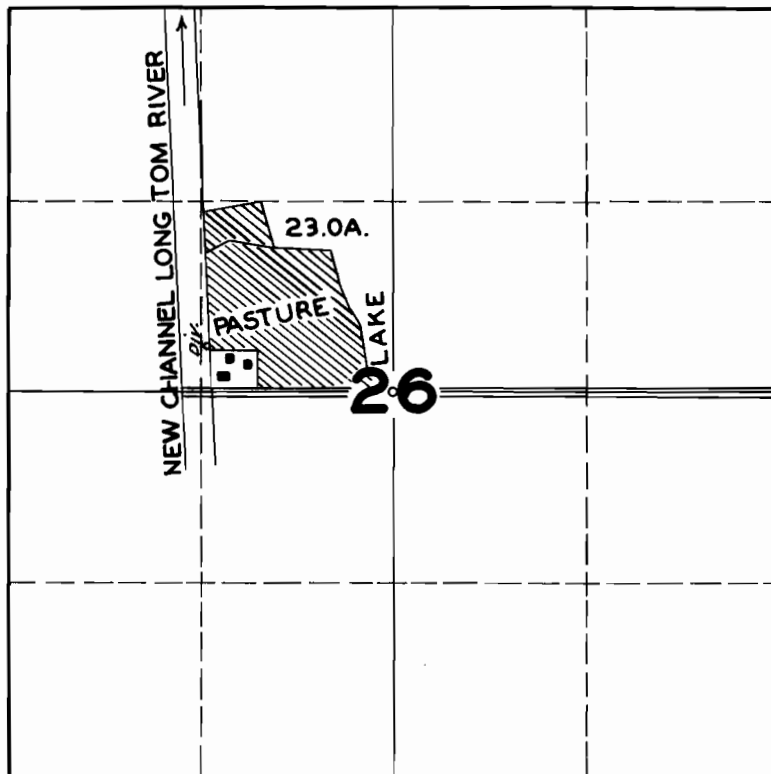

FINAL PROOF SURVEY

UNDER

Application No. **22061** Permit No. **17328**

IN NAME OF

H.E. SPICKLER

Surveyed **JUNE 18, 1948**, by **JAS. E. BUNNELL**