


T.5S. R.1E.W.M.

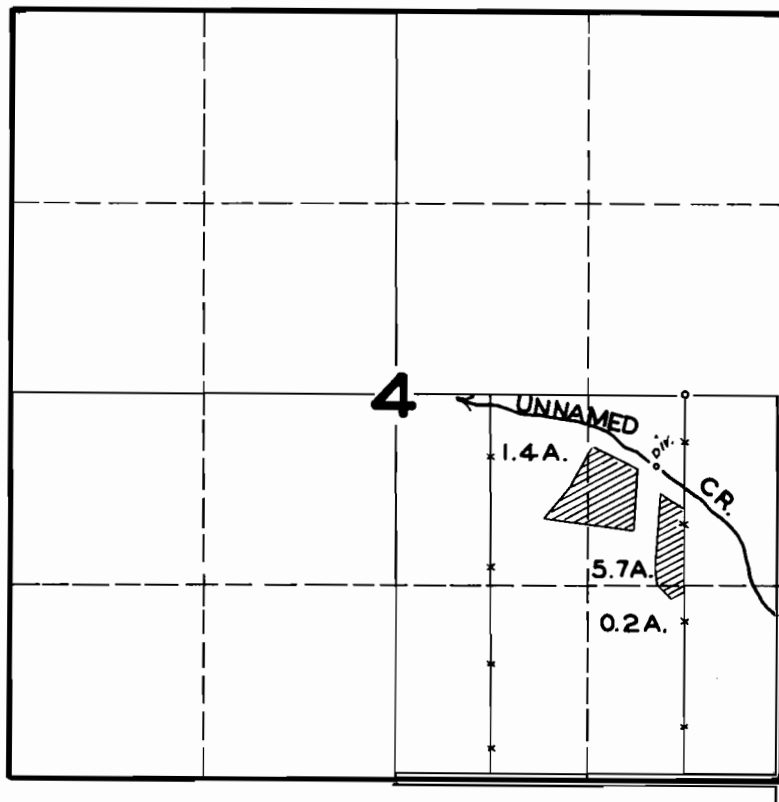

FINAL PROOF SURVEY

UNDER

Application No. **22038**. Permit No. **17359**...

IN NAME OF

H.R. EDMONDS

Surveyed **AUG. 5**, 1948, by **JAS. E. BUNNELL**