


# T. IS. R. IW. W. M.

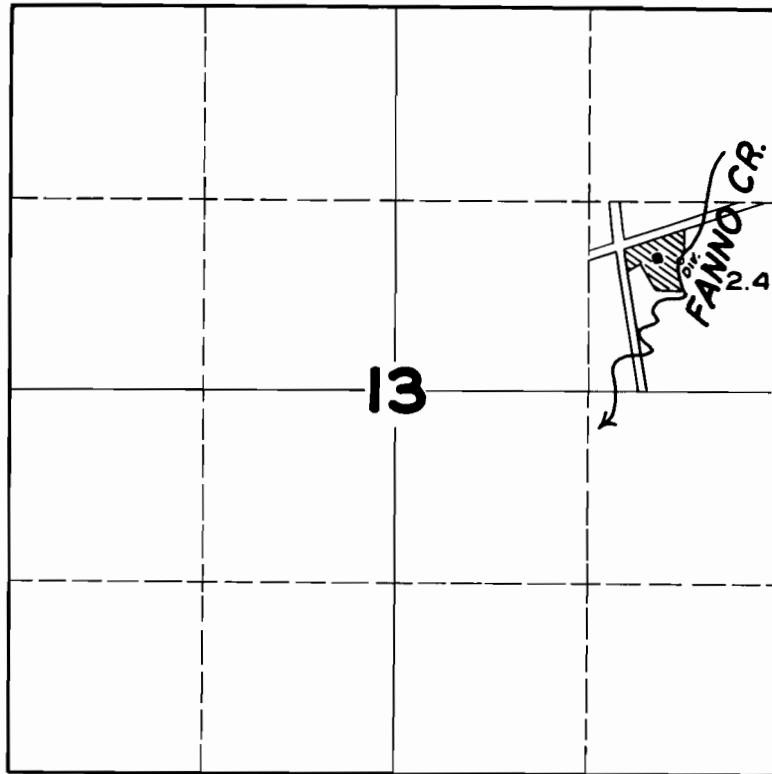

## FINAL PROOF SURVEY UNDER

Application No. **22072** Permit No. **17366**  
IN NAME OF

**ARTHUR SUSSMAN**

Surveyed **MAY 6** 19**48**, by **JAS. E. BUNNELL**