


T.I.S.R.I.W.W.M.

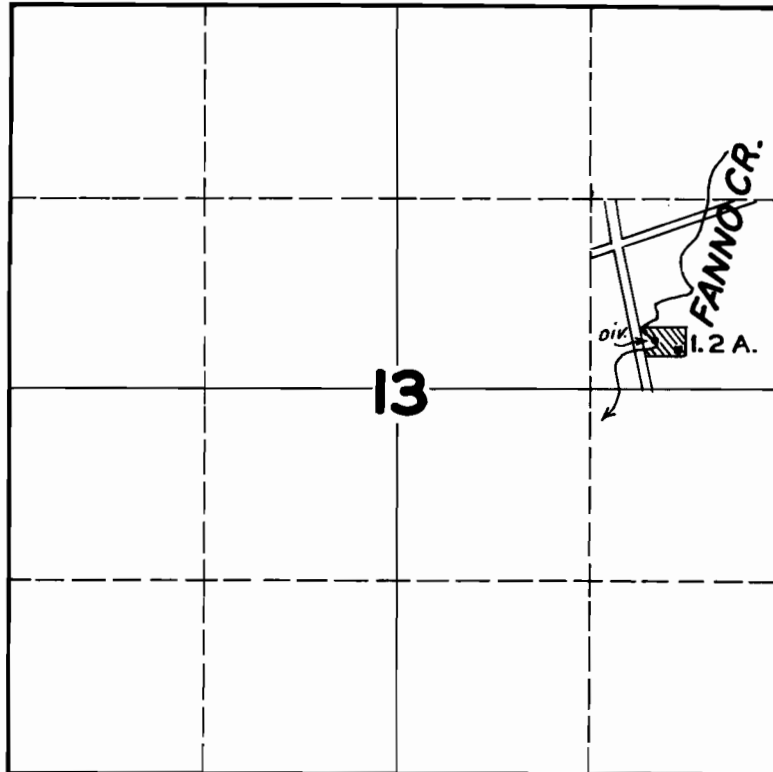

FINAL PROOF SURVEY UNDER

Application No. 22053 Permit No. 17405
IN NAME OF

ARTHUR E. FRY

Surveyed MAY 6 1948, by JAS. E. BUNNELL