


T. 22 S. R. 9 W. W. M.

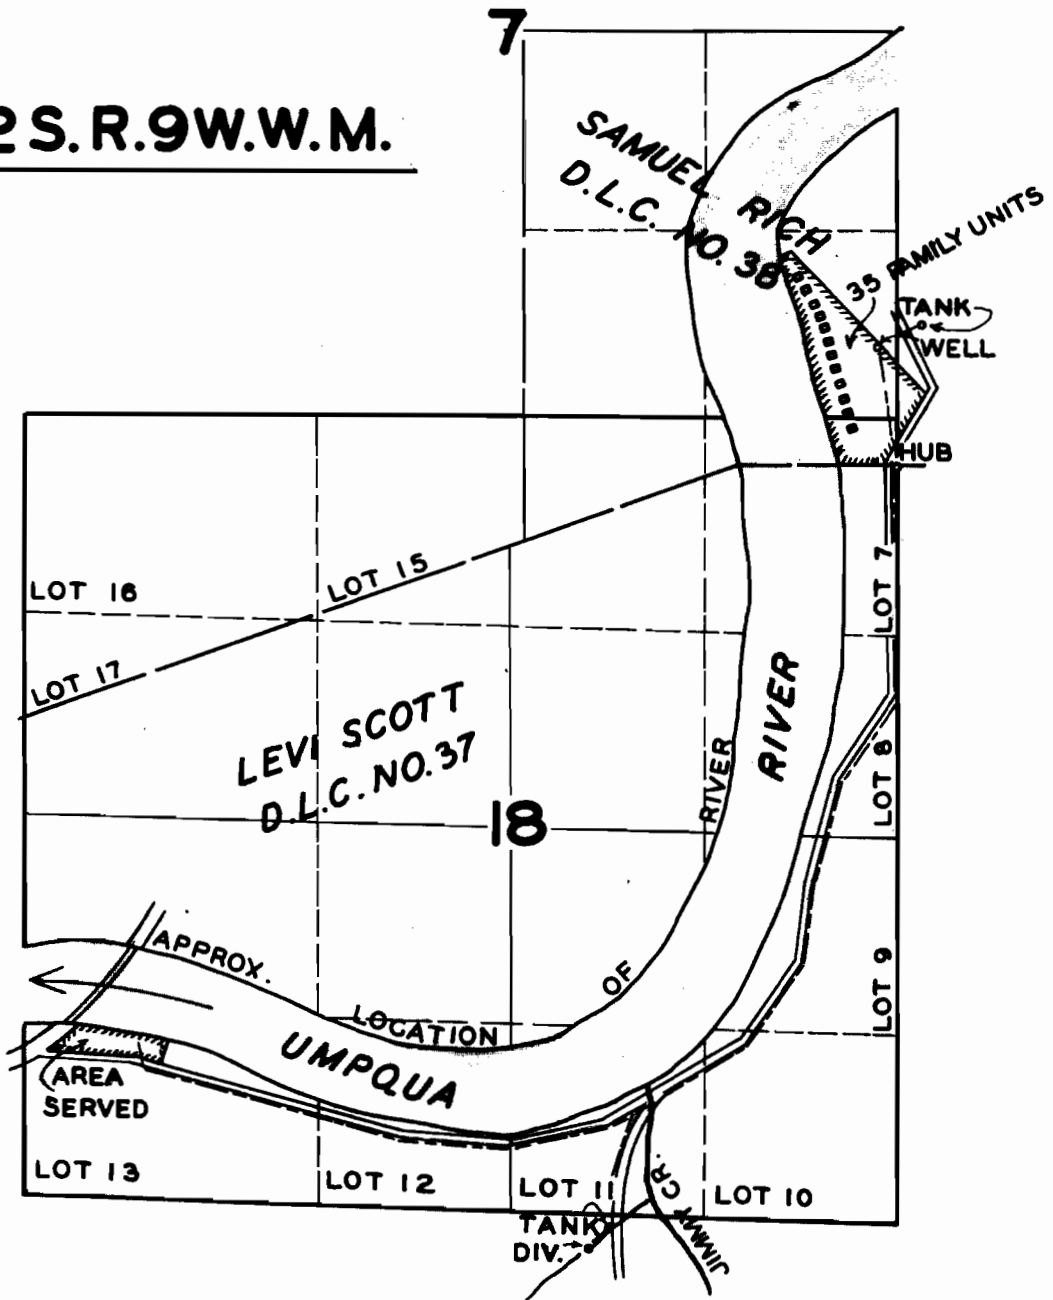

**FINAL PROOF SURVEY
UNDER**

Application No. 22149 Permit No. 17442

IN NAME OF

O.H. HINSDALE, PRES.-GARDINER LUMBER COMPANY

Surveyed JULY 14 1948, by JAS. E. BUNNELL