


T.19S.R.3W.W.M.

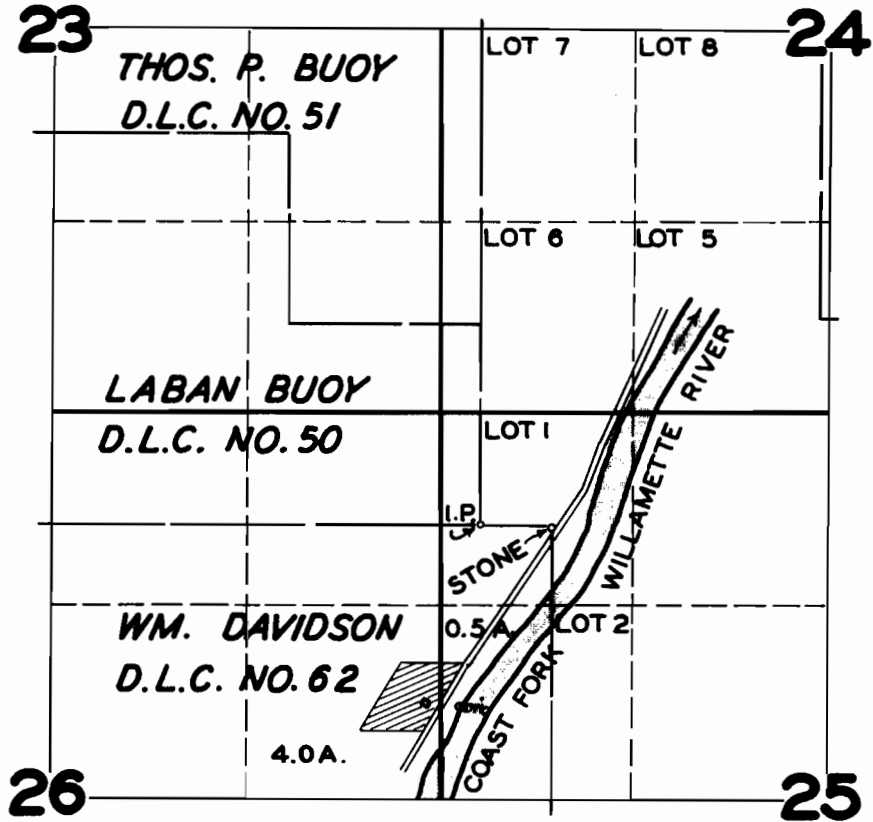

FINAL PROOF SURVEY
UNDER

Application No. **22218**... Permit No. **17537**....

IN NAME OF

A. E. ELLIOTT

Surveyed **JUL. 19. 1948**, by **JAS. E. BUNNELL**