


T.7S. R.3W.W.M.

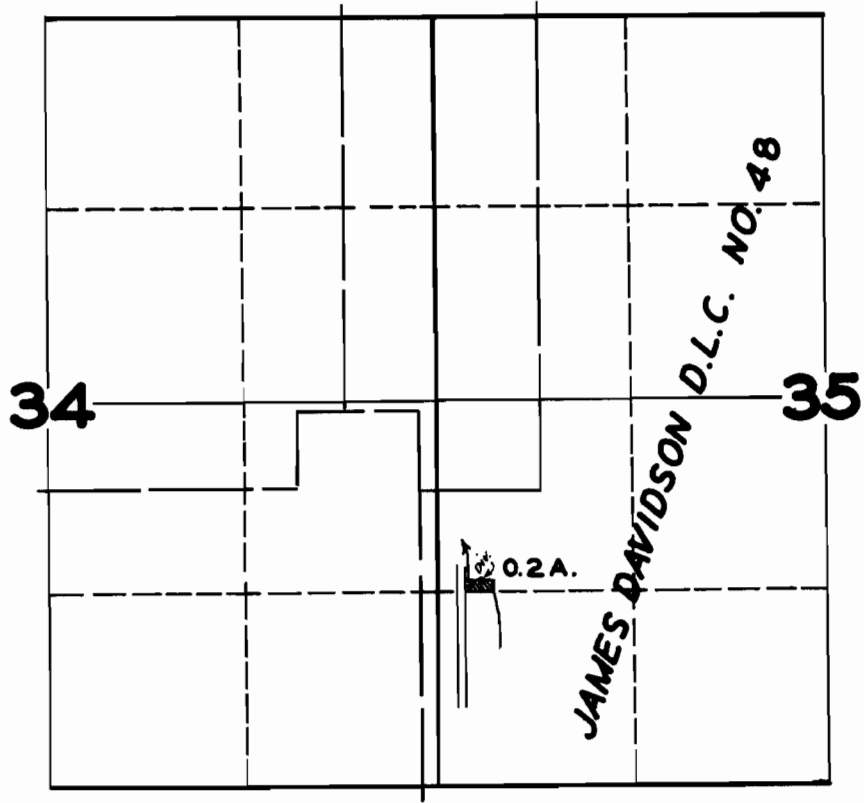

FINAL PROOF SURVEY
UNDER

Application No. **22261**... Permit No. **17557**...
IN NAME OF

OREN MCDOWELL

Surveyed **SEP. 3**... 1947, by **JAS. E. BUNNELL**