


T.18S.R.10W.W.M.

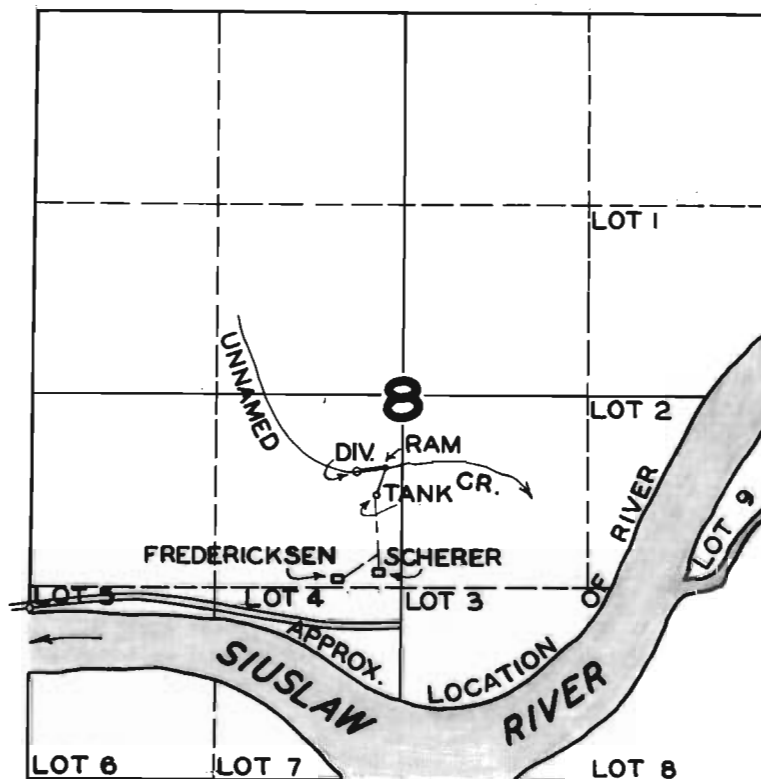

FINAL PROOF SURVEY
UNDER

Application No. **22293** Permit No. **17579**....
IN NAME OF

DAVID F. SCHERER & CARL FREDERICKSEN

Surveyed **JUL. 26 1948**, by **JAS. E. BUNNELL**