


T.2S.R.2E.W.M.

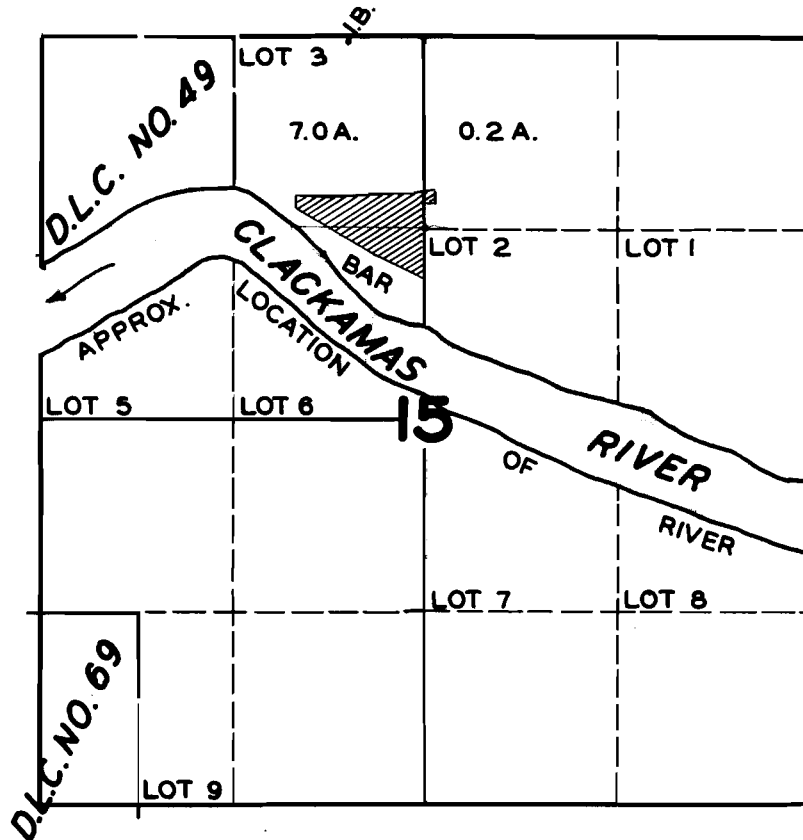

FINAL PROOF SURVEY

UNDER

Application No. **22328** Permit No. **17605**.....

IN NAME OF

.....**S.L. CARLI**.....

Surveyed **AUG. 12, 1948**, by **JAS. E. BUNNELL**