


T.14S.R.6W.W.M.

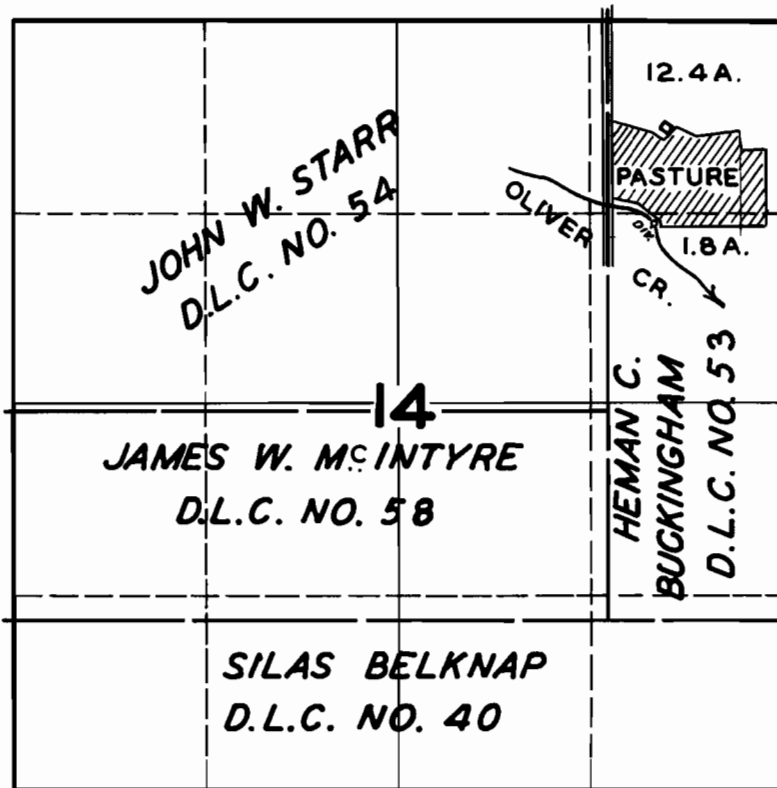

FINAL PROOF SURVEY

UNDER

Application No. **22340** Permit No. **17615**

IN NAME OF

ROBERT & DORTHY BAKER

Surveyed **AUG. 27 1948**, by **JAS. E. BUNNELL**