


T.2S.R.5E.W.M.

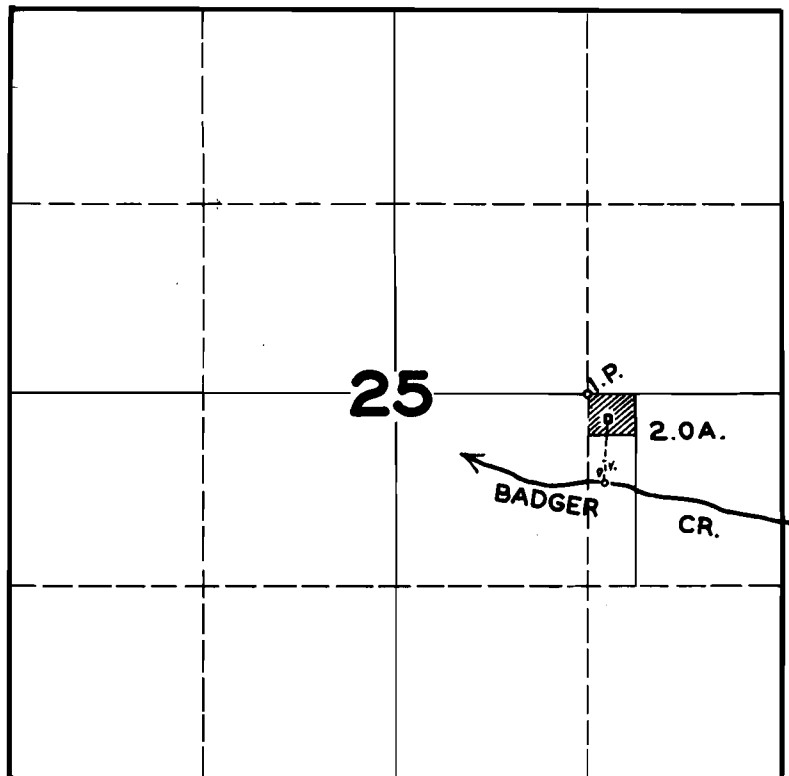

FINAL PROOF SURVEY
UNDER

Application No. **22353** Permit No. **17624**
IN NAME OF

I. TEURMAN

Surveyed **SEP. 15** 1948, by **JAS. E. BUNNELL**