


T.3S. R.2E.W.M.

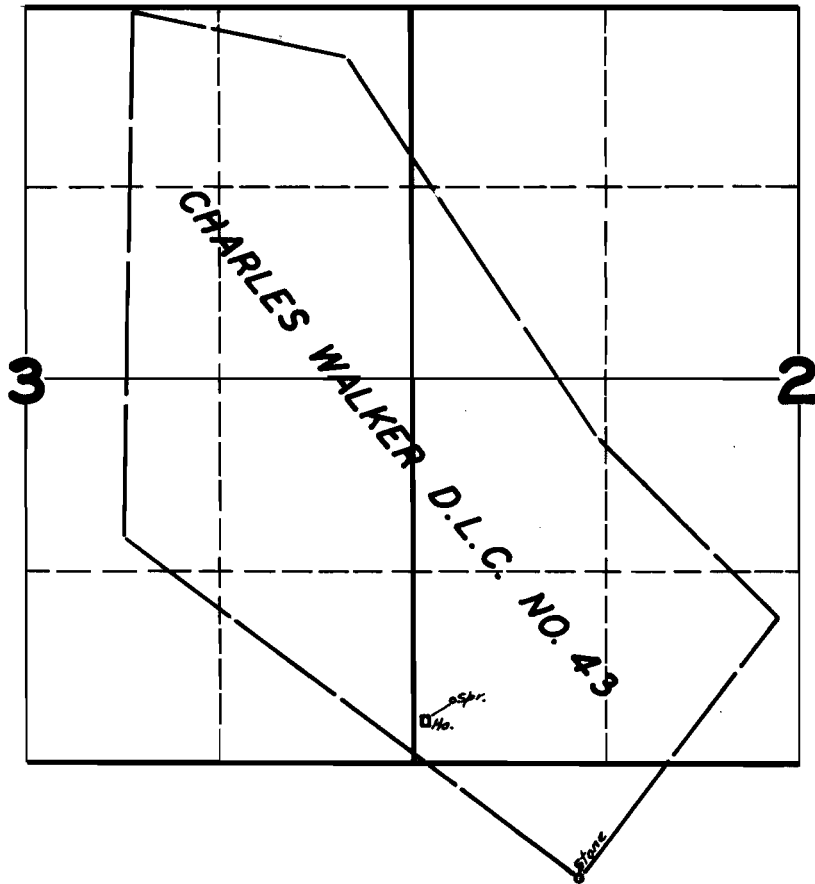

**FINAL PROOF SURVEY
UNDER**

Application No. 22406 Permit No. 17662

IN NAME OF

CLARENCE TRIBITT

Surveyed SEP. 8, 1947, by JAS. E. BUNNELL