


T.5S.R.7W.W.M.

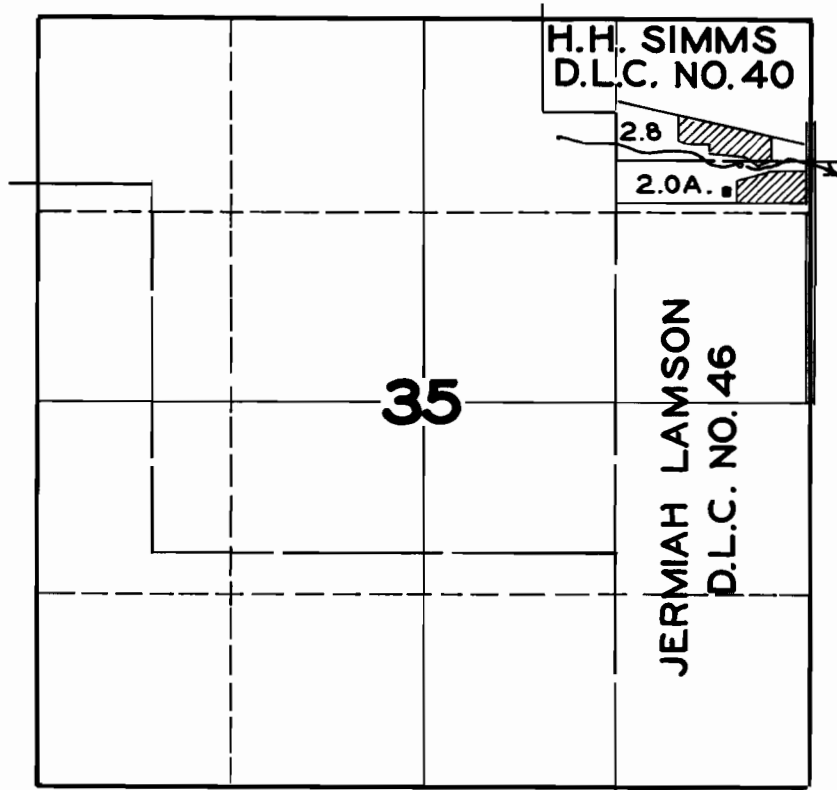

FINAL PROOF SURVEY

UNDER

Application No. **22600** Permit No. **17782**

IN NAME OF

HERMAN BATE

Surveyed **JUNE 12 1948**, by **JAS. E. BUNNELL**