


T.2S.R.3E.W.M.

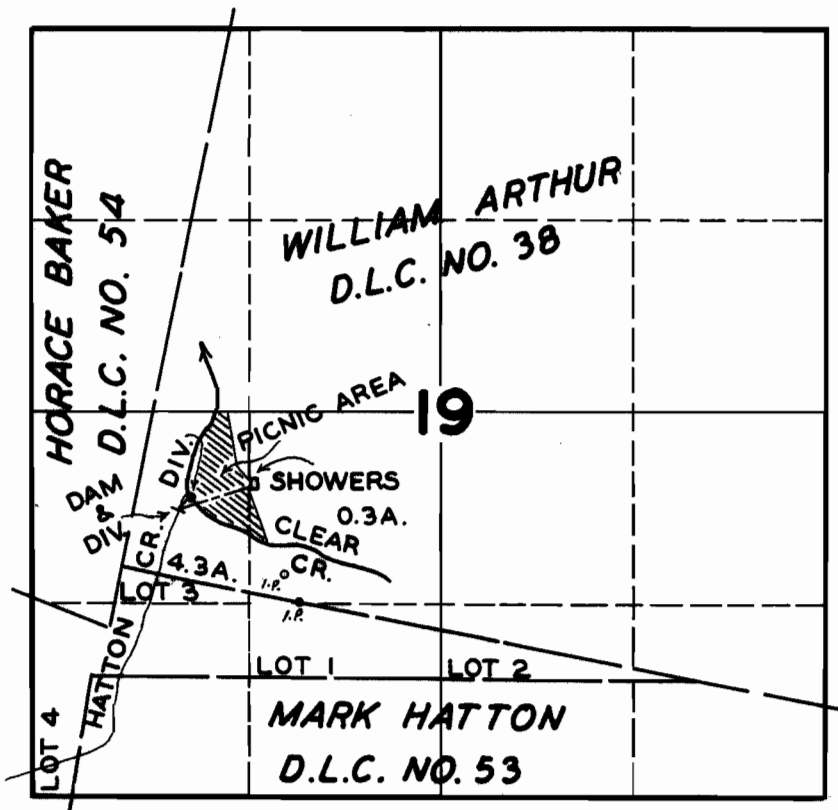

FINAL PROOF SURVEY UNDER

Application No. 22455 Permit No. 17683
IN NAME OF

MILO MUMPOWER

Surveyed SEP. 3 1948, by JAS. E. BUNNELL