


**T.9S.R.3W.W.M.**

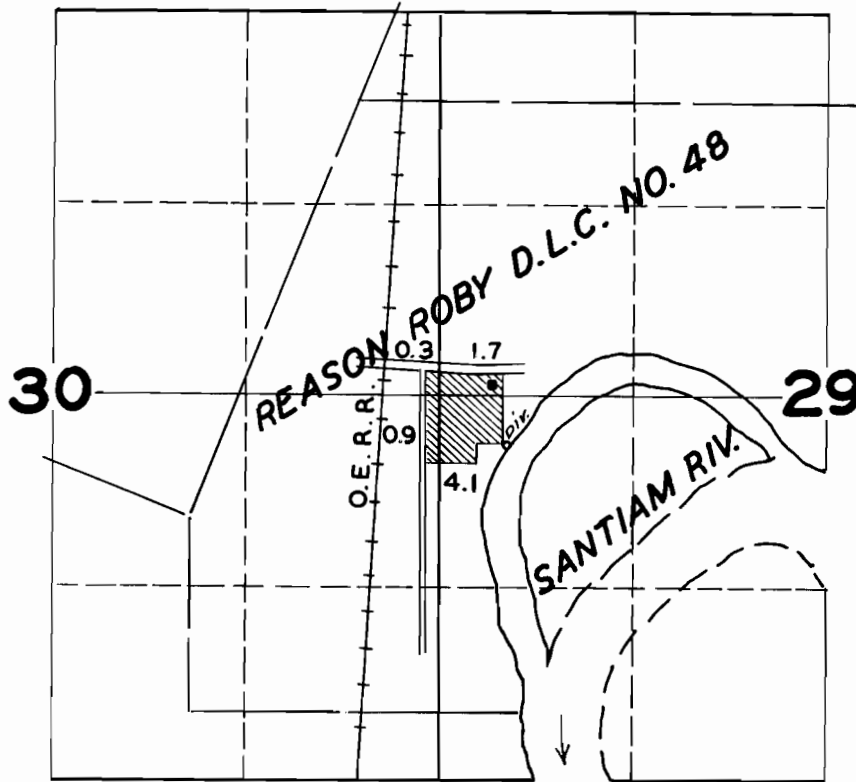

**FINAL PROOF SURVEY**

UNDER

Application No. **22612** Permit No. **17827**

IN NAME OF

**O. A. JORGENSEN**

Surveyed **MAR. 30 1949**, by **JAS. E. BUNNELL**