


**T.3S.R.5W.W.M.**

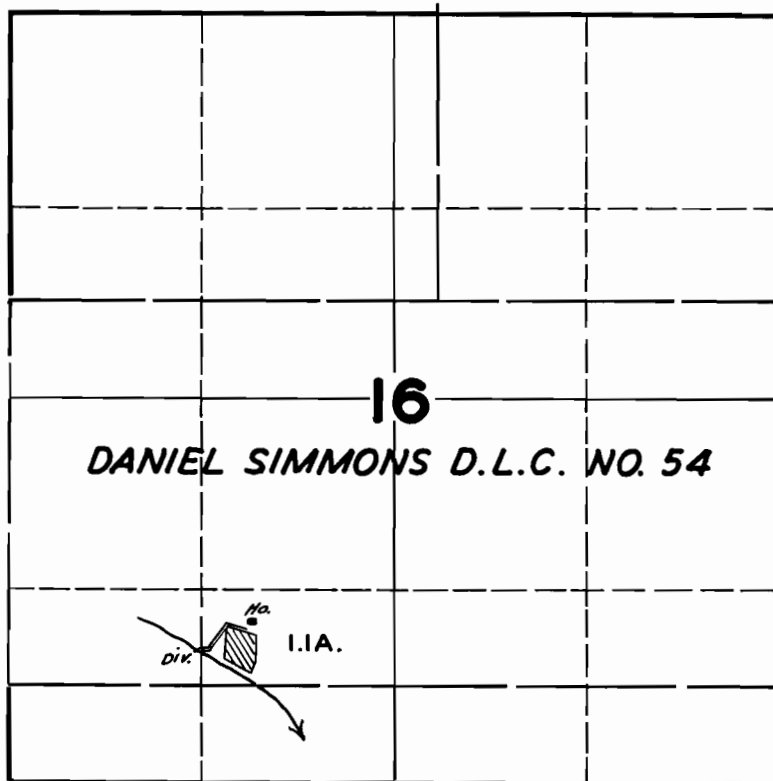

**FINAL PROOF SURVEY**

UNDER

Application No. **22521**.. Permit No. **17880**....

IN NAME OF

**ALONZO & HELEN VAUGHN**

Surveyed **SEP. 8** 1948, by **JAS. E. BUNNELL**