


T.6S.R.8W.W.M.

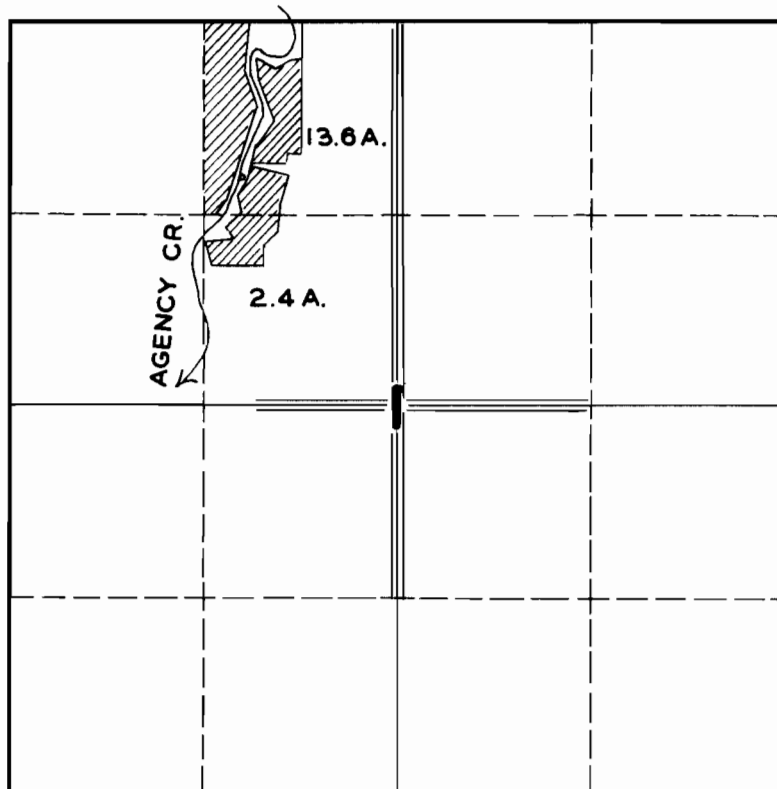

FINAL PROOF SURVEY

UNDER

Application No. **22829** Permit No. **17963**

IN NAME OF

JOHN H. SMITH

Surveyed **APR. 7** 1949, by **JAS. E. BUNNELL**