


T.16S. R.4E. W. M.

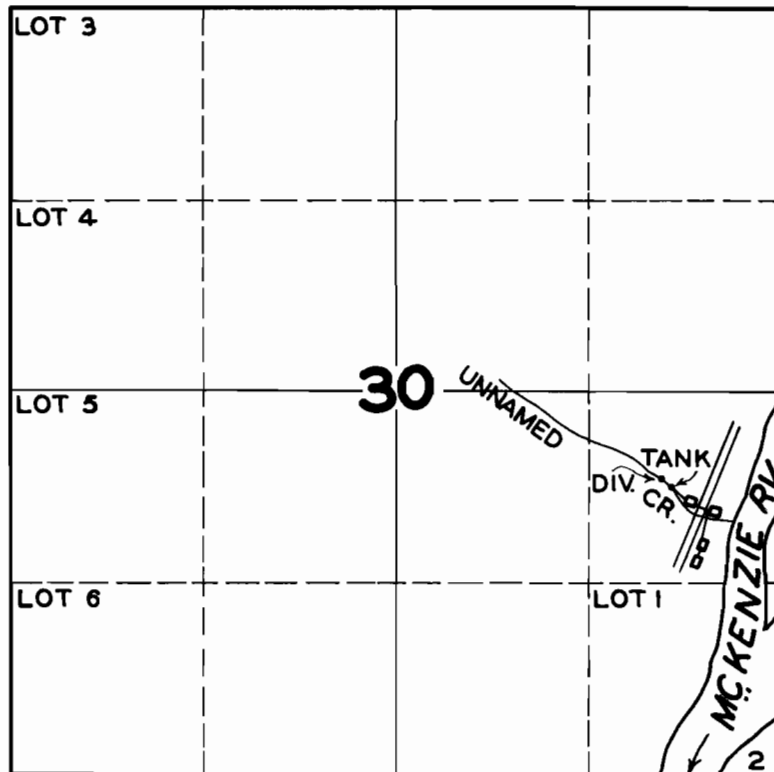

FINAL PROOF SURVEY
UNDER

Application No. **22797** Permit No. **17979**
IN NAME OF

F. W. SCOBERT

Surveyed **JUNE 15 1948**, by **JAS. E. BUNNELL**