


T.6S.R.8W.W.M.

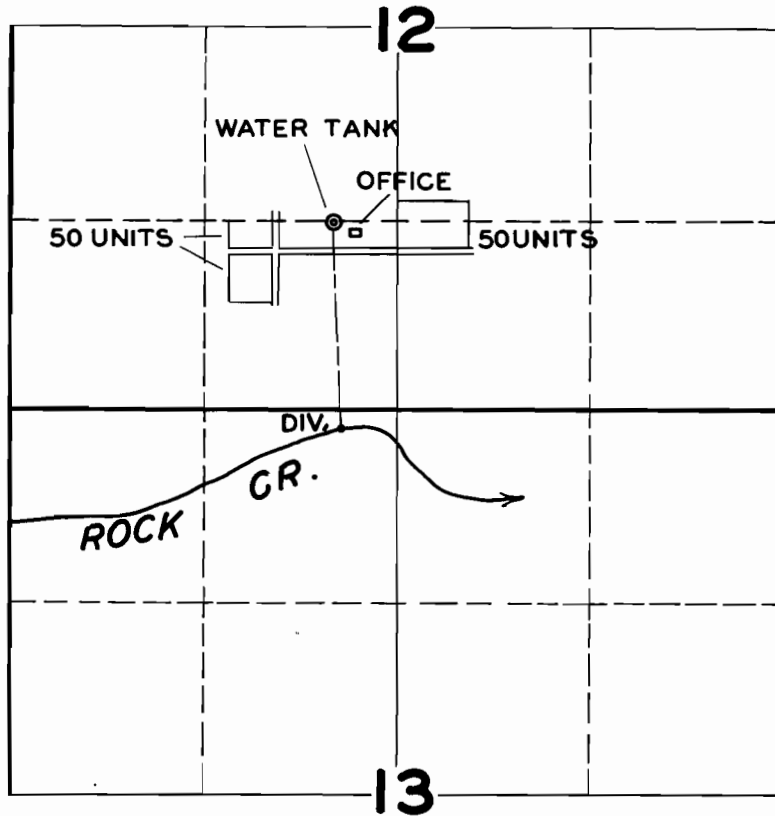

**FINAL PROOF SURVEY**

UNDER

Application No. **22659** Permit No. **18022**

IN NAME OF

**NATIONAL HOUSING AGENCY-FEDERAL PUBLIC HOUSING AUTHORITY**

Surveyed **JUNE 12 1948**, by **JAS. E. BUNNELL**