


T.15S. R.12W.W.M.

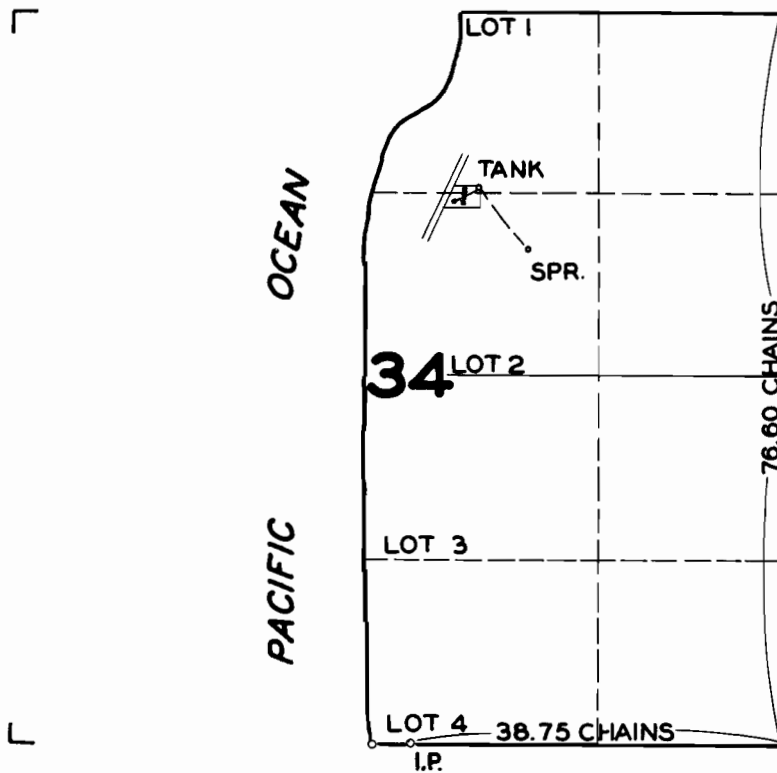

FINAL PROOF SURVEY
UNDER

Application No. **22762** Permit No. **18034**
IN NAME OF

LILLIAN JONES

Surveyed **JUL. 27, 1948**, by **JAS. E. BUNNELL**