


T.4S.R.10W.W.M.

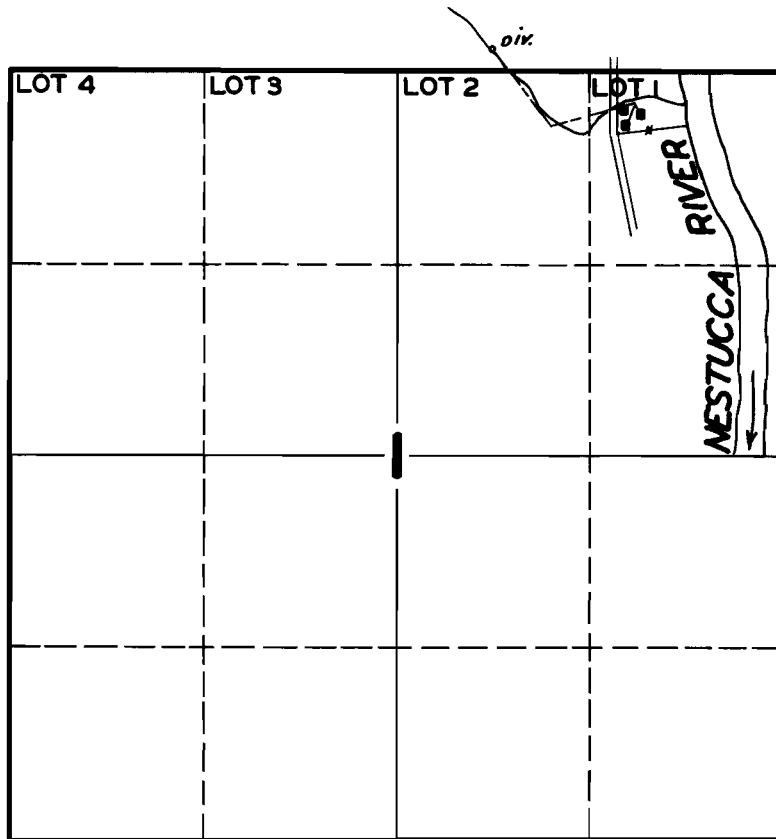

FINAL PROOF SURVEY UNDER

Application No. 22927 Permit No. 18073
IN NAME OF

HOWARD G. FORSYTHE

Surveyed SEP. 1 1948, by JAS. E. BUNNELL