


T.9S.R.3E.W.M.

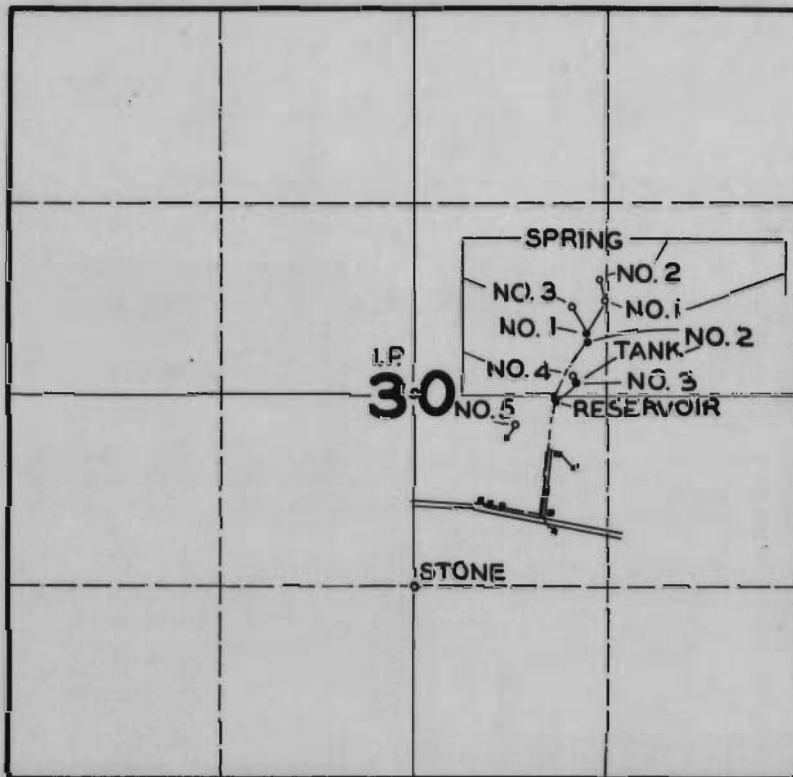

FINAL PROOF SURVEY UNDER

Application No. 22979 Permit No. 18131
IN NAME OF

FRANK RADA

Surveyed MAY 10 1948 by JAS. E. BUNNELL