


T.3S.R.5W.W.M.

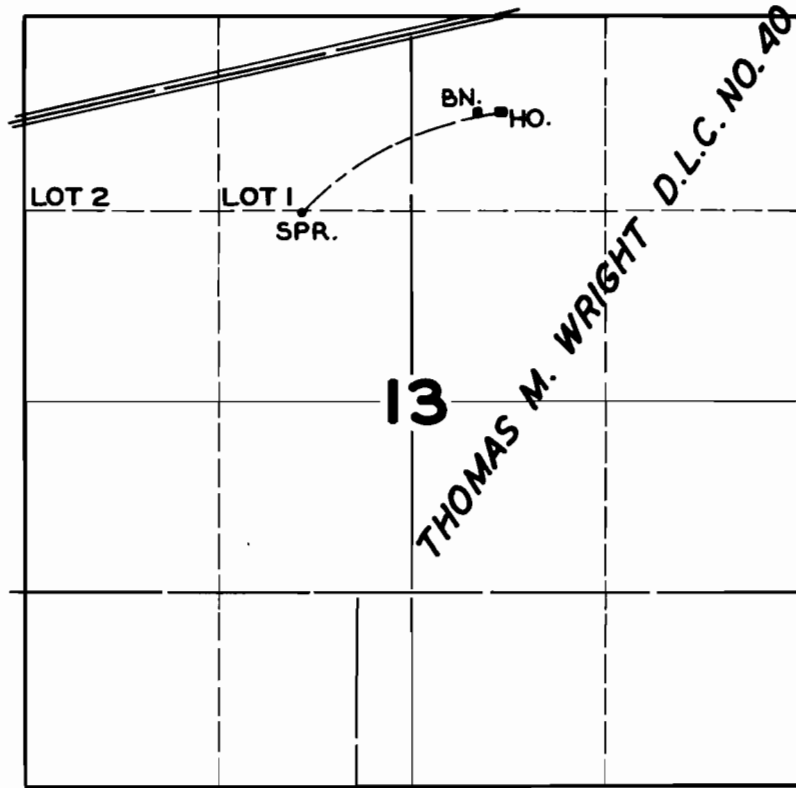

FINAL PROOF SURVEY

UNDER

Application No. **23036** Permit No. **18149**
IN NAME OF

EARL B. MILLER

Surveyed **AUG. 23 1948**, by **JAS. E. BUNNELL**