


T.3S.R.4W.W.M.

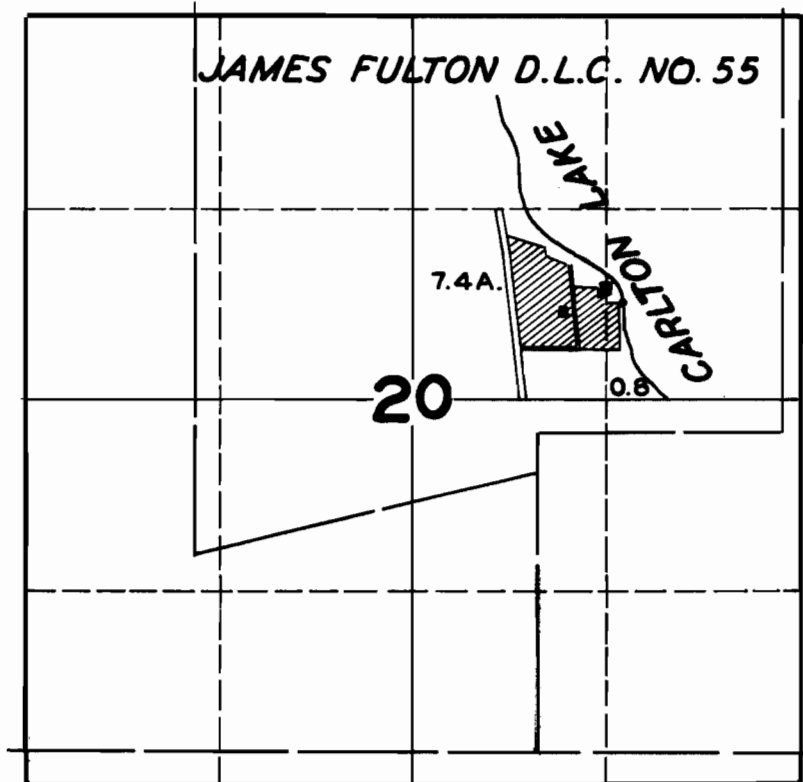

FINAL PROOF SURVEY

UNDER

Application No. 23156 Permit No. 18242

IN NAME OF

RANSOM B. CARTER

Surveyed AUG. 23 1948, by JAS. E. BUNNELL