


**T.2S.R.2E.W.M.**

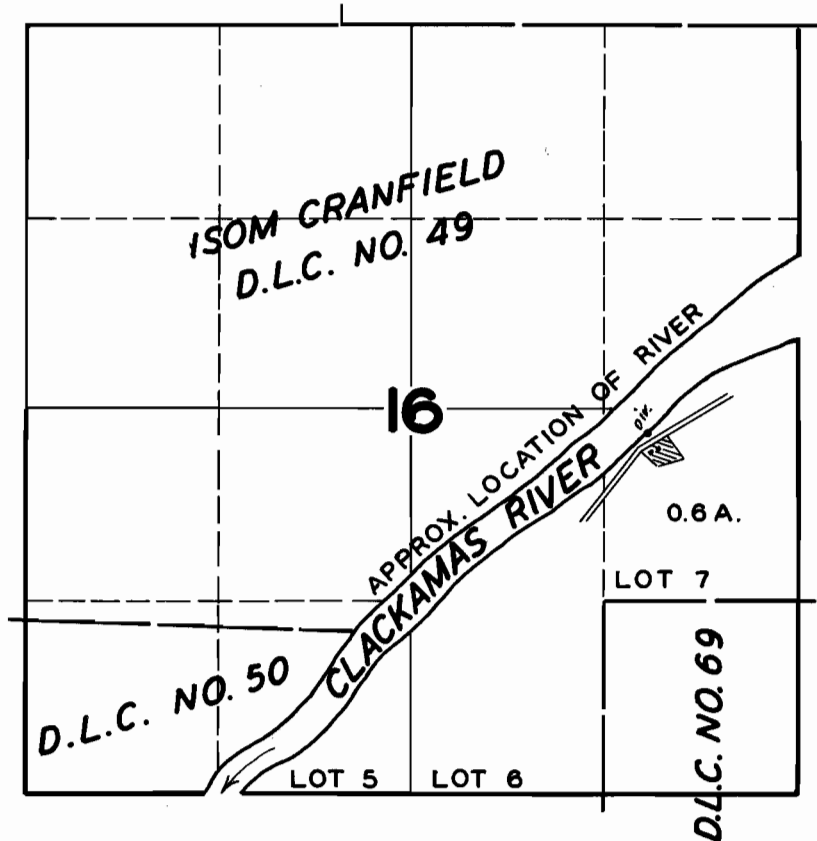

**FINAL PROOF SURVEY**  
UNDER

Application No. **23231**... Permit No. **18309**...  
IN NAME OF

**Laurin E. Hinman**

Surveyed **SEP. 27, 1948**, by **JAS. E. BUNNELL**