


T.8S.R.6W.W.M.

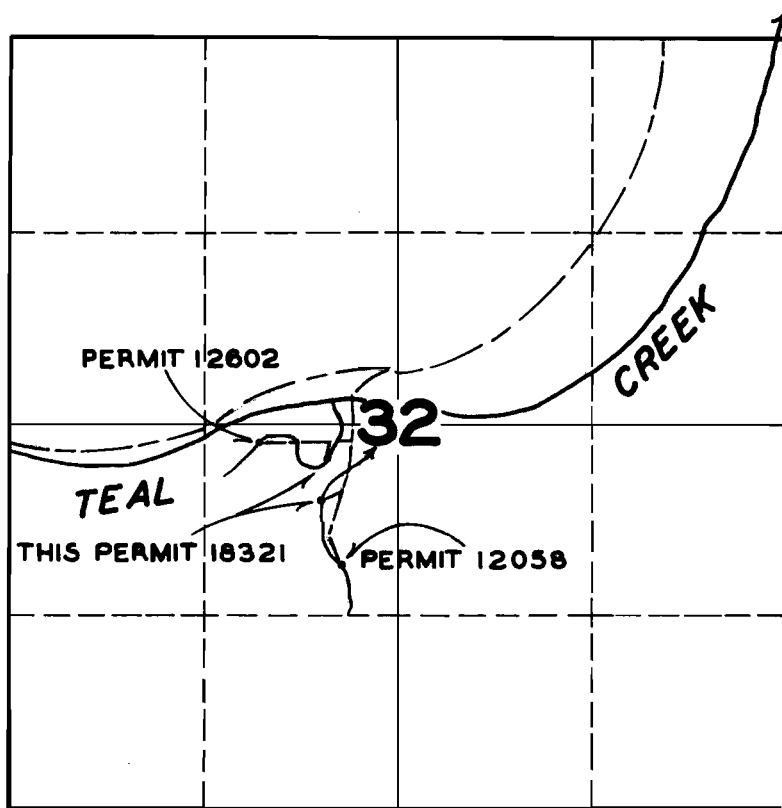

FINAL PROOF SURVEY

UNDER

Application No. 22133 Permit No. 18321

IN NAME OF

CITY OF MONMOUTH

Surveyed APR. 13 1949, by JAS. E. BUNNELL