


T.5S.R.3E.W.M.

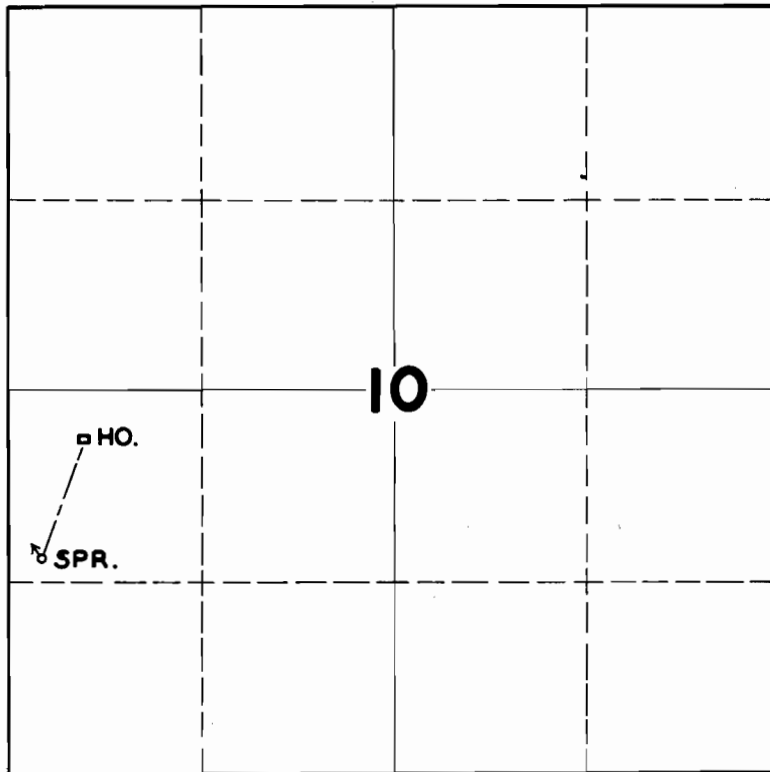

FINAL PROOF SURVEY UNDER

Application No. 23273 Permit No. 18366
IN NAME OF

JOSEPH LEAUTAUD

Surveyed MAR. 10, 1949, by JAS. E. BUNNELL