


T.3S.R.3W.W.M.

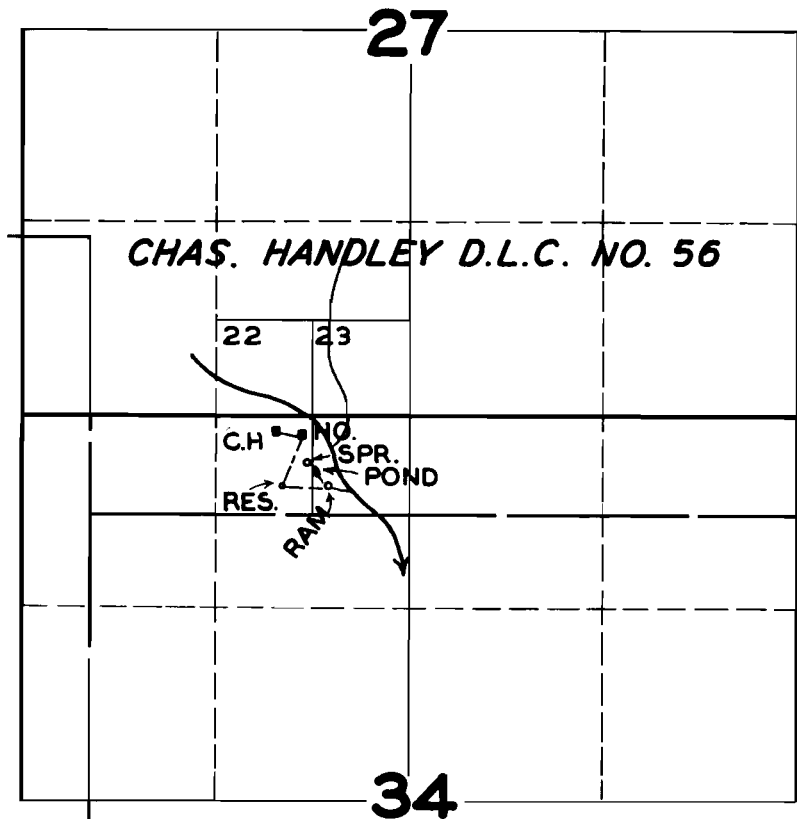

FINAL PROOF SURVEY

UNDER

Application No. **23539** Permit No. **18587**

IN NAME OF

AXEL L. WESTBERG

Surveyed **MAY 14, 1948**, by **JAS. E. BUNNELL**