


T. 1N. R. 13E. W.M.

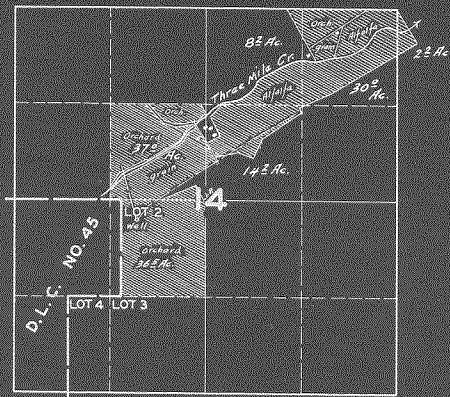

FINAL PROOF SURVEY
UNDER

Application No. U-75 Permit No. U-66

IN NAME OF

DEWEY WAGONBLAST

Surveyed APR. 18, 1947, by JAS. E. BUNNELL