


# T.6N.R.35E.W.M.

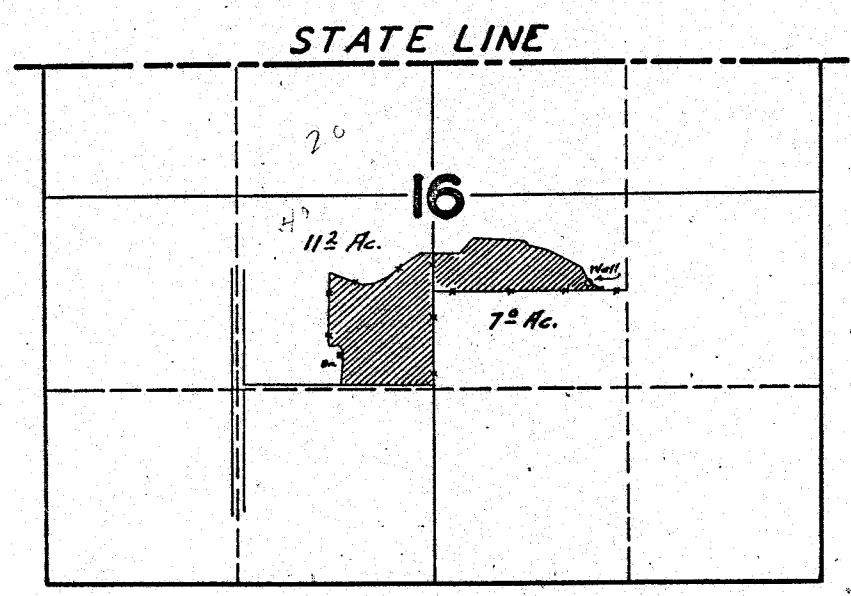

## FINAL PROOF SURVEY UNDER

Application No. U-84 Permit No. U-77

IN NAME OF

P. E. & NANNY OLIVER

Surveyed APR. 22 1947, by JAS. E. BUNNELL