


T.4N.R.35E.W.M.

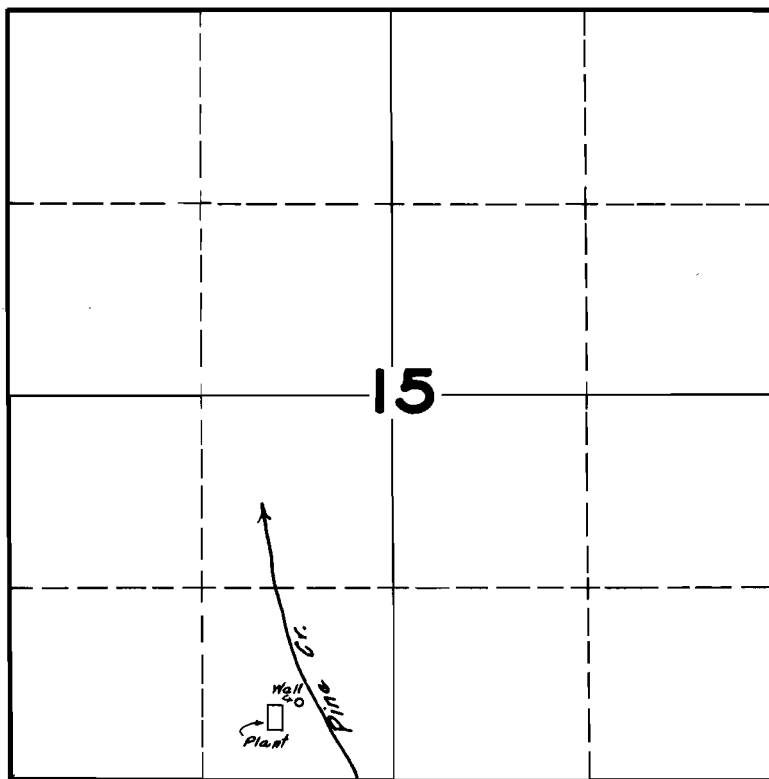

FINAL PROOF SURVEY

UNDER

Application No. U-182 Permit No. U-171

IN NAME OF

EASTERN OREGON FOODS CO-OP

Surveyed APR. 23 1947, by JAS. E. BUNNELL