


# T.5N.R.35E.W.M.

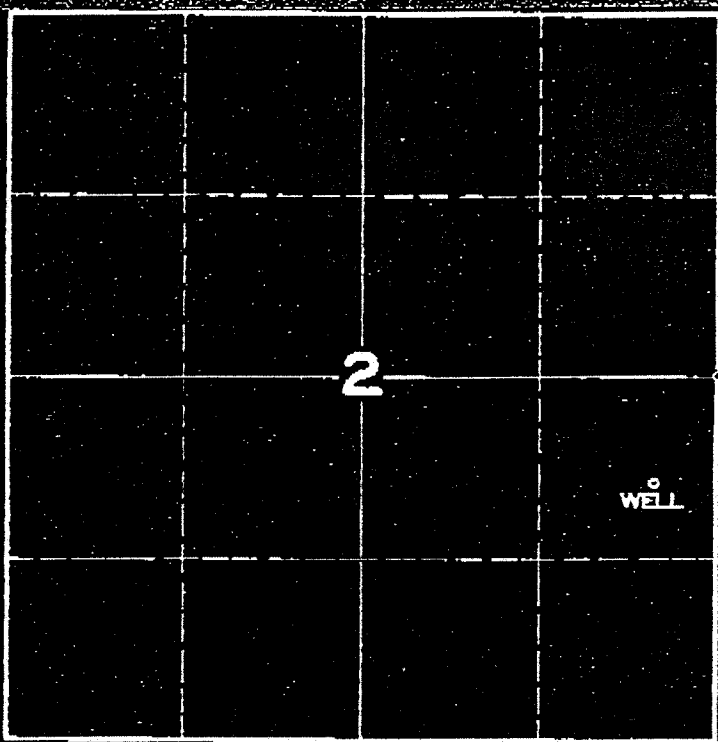

## FINAL PROOF SURVEY UNDER

Application No. U-191 Permit No. U-172

IN NAME OF

MILTON CITY, A MUNICIPAL CORPORATION

Surveyed APR. 22 1947, by JAS. E. BUNNELL

1947-A

C-16998