


Willow Creek Adjudication

Part 3 S. 26  
2 S. 26

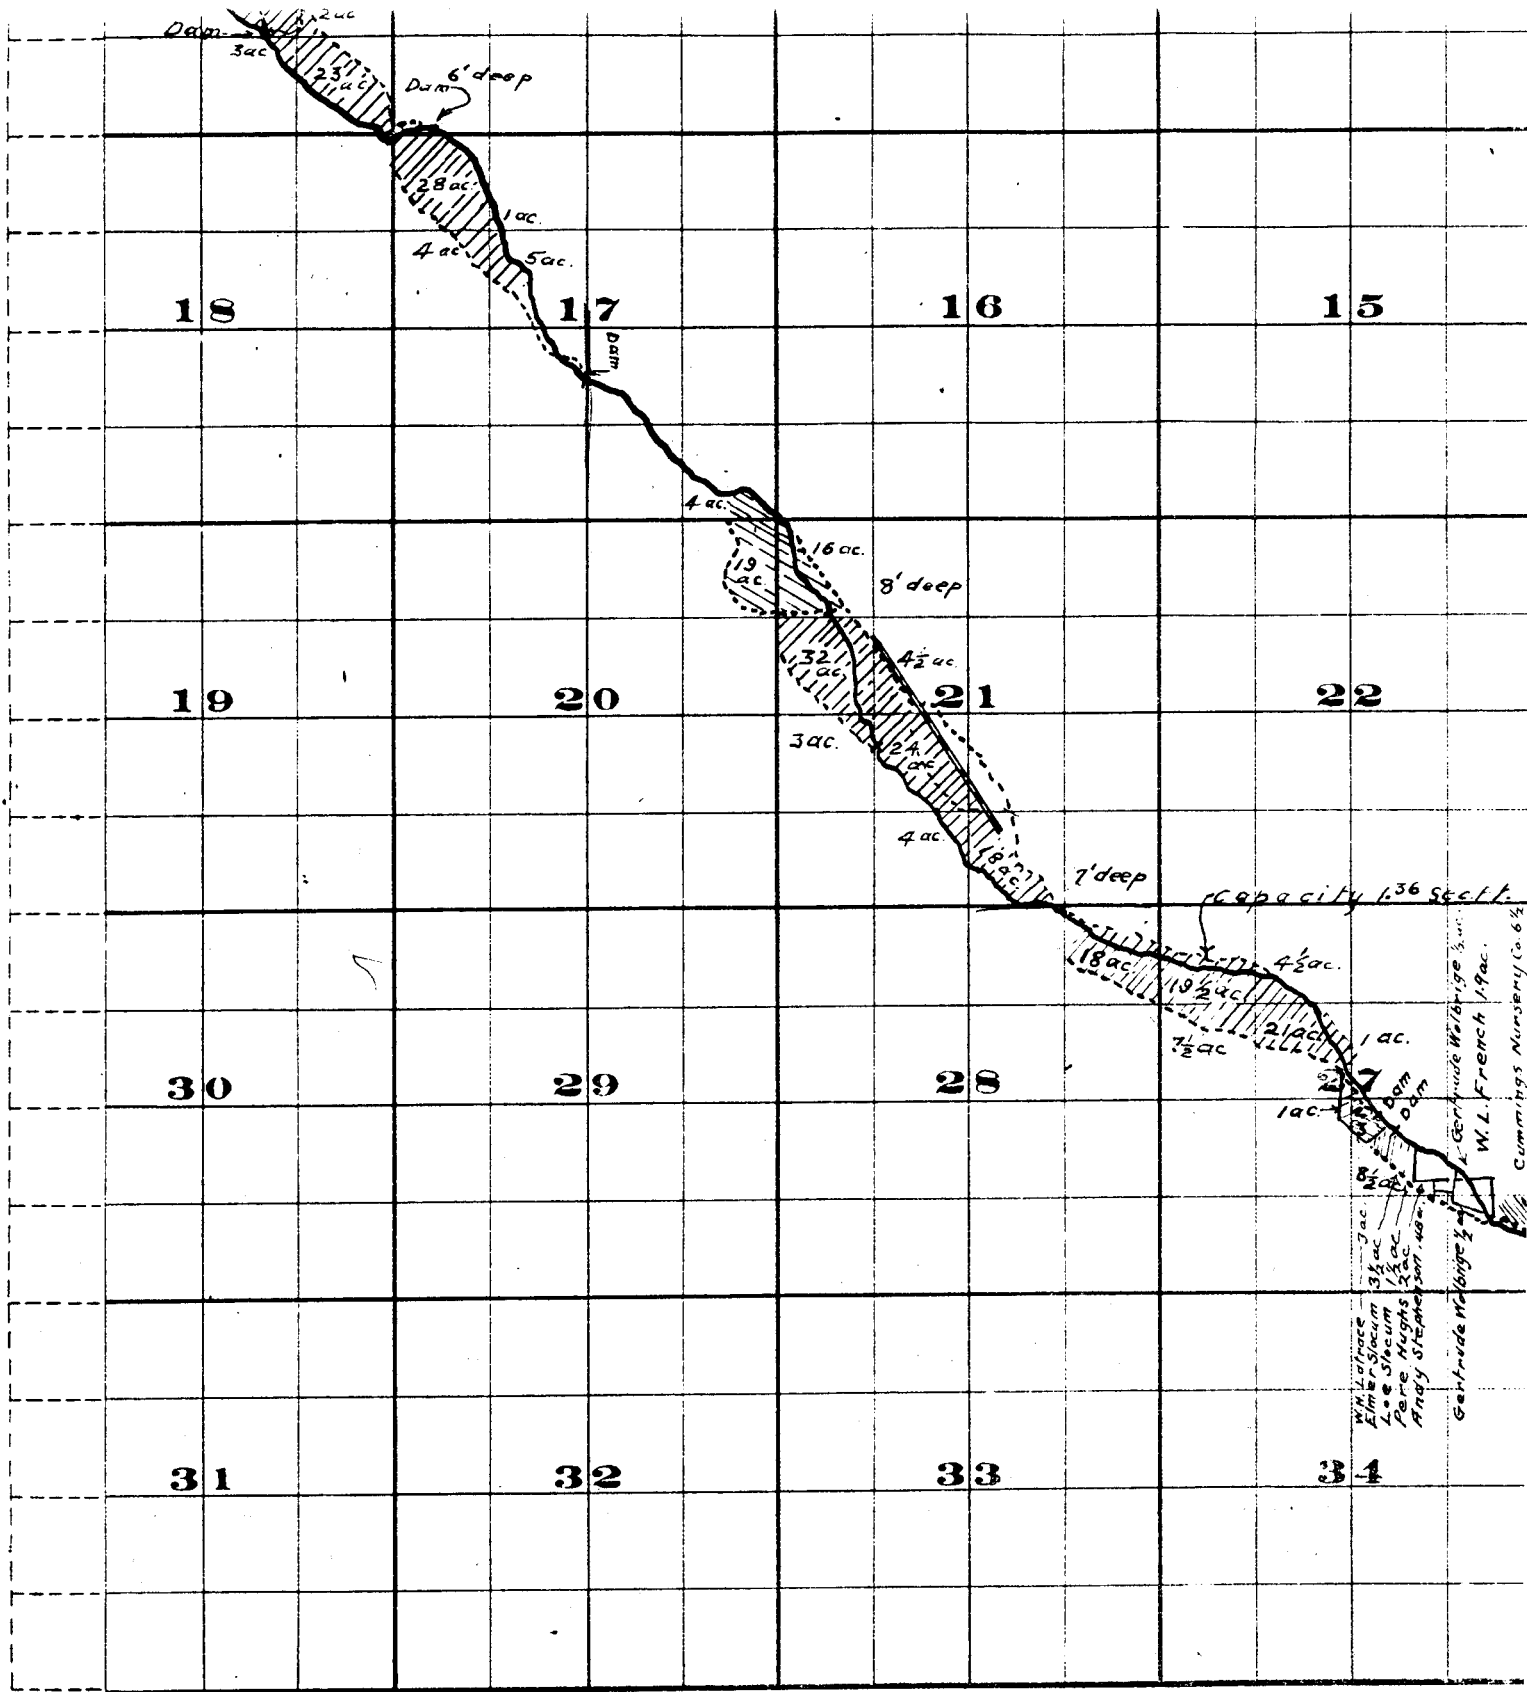


THE B & BRISTOL CO., PRINTERS & BOUNDERS CHATTANOOGA, TENN.

Surveyed by R.D. Cooper July 1909  
 John H. Lewis - State Engineer.  
 Examined July 14, 1909.



# Township 2 S.

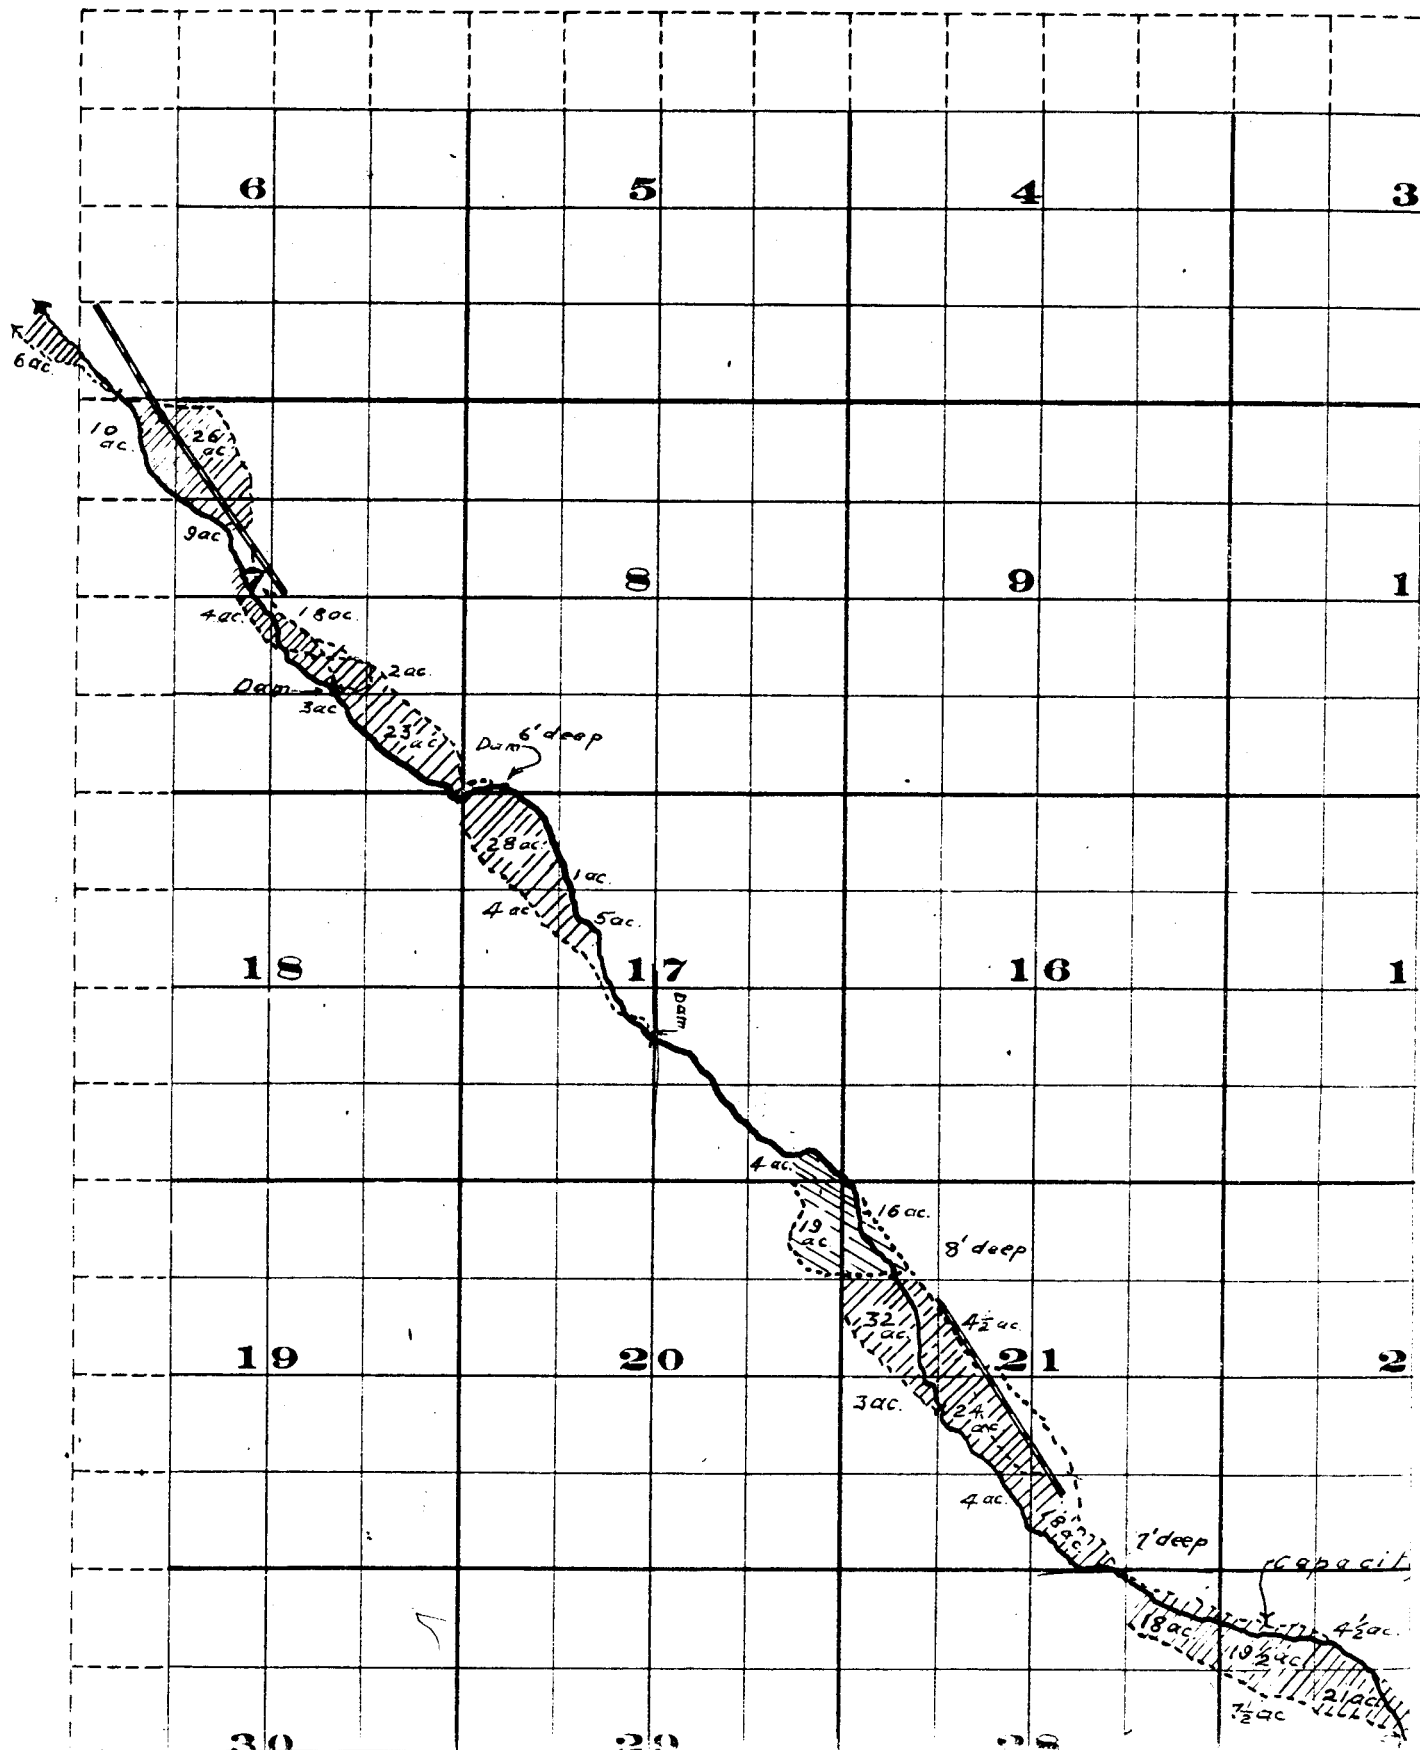

S. , Range 26 E.W.M.

