


T.6N. R.35E.W.M.

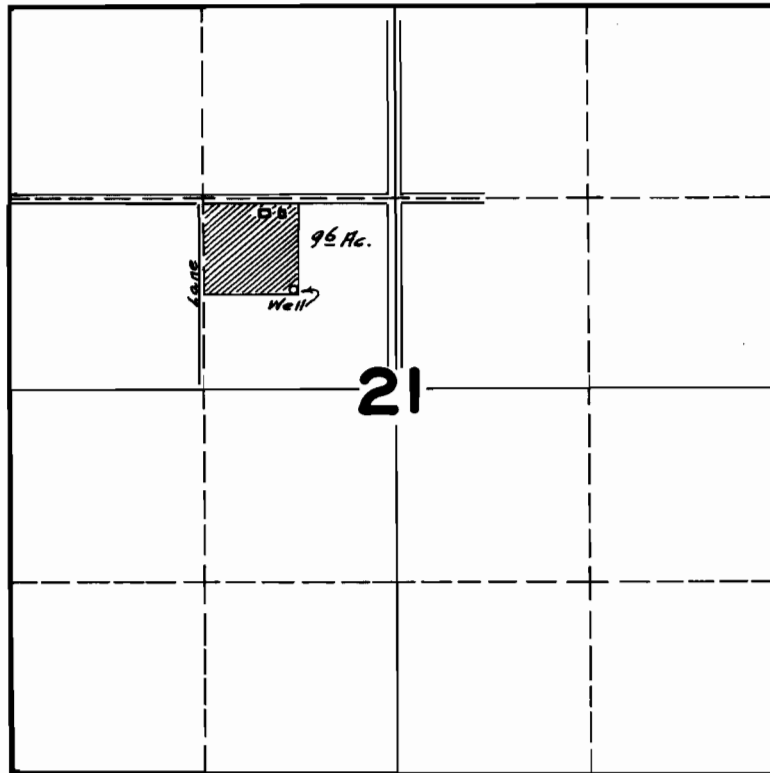

**FINAL PROOF SURVEY
UNDER**

Application No. U-196 Permit No. U-178

IN NAME OF

ALBERT OLSON

Surveyed APR. 21 1947, by JAS. E. BUNNELL