


T.4S.R.2E.W.M.

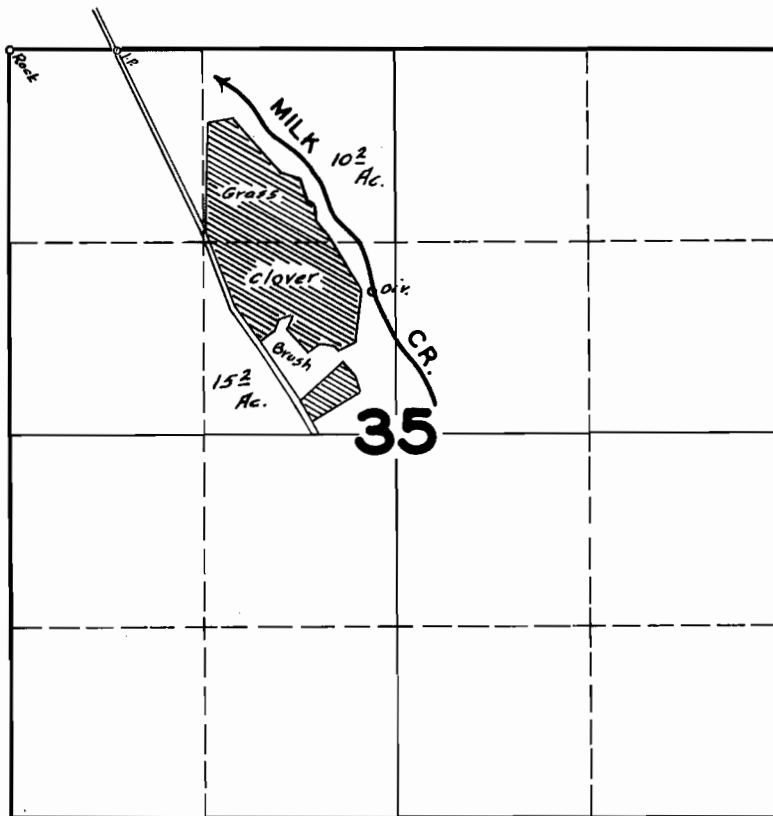

FINAL PROOF SURVEY UNDER

Application No. 18899 Permit No. 14514

IN NAME OF

MRS. O.M. LARKINS

Surveyed JUN. 13, 1947, by JAS. E. BUNNELL